

Newton  
714  
8-2-68

MISSISSIPPI  
BOARD OF WATER COMMISSIONERS  
416 North State Street  
Jackson, Mississippi 39201

CODED

WATER WELL DRILLERS LOG

8-0 1968 Cannon Drilling Newton  
date well completed firm name county well located

LANDOWNER: George F Zell

description of formations encountered

from to

R/L Ducture

Dark Clay 0 16

MISS  
(mailing address)

Red & sand  
log 16 18

WELL LOCATION:

sec. 15 T 7 N R 11 E  
S W  
2 miles W of Ducture  
(distance) (direction) (nearest town)

Dark Clay 18 120

WELL PURPOSE: HOME  
(home, irrigation, municipal, industrial)

White Sand 120 175

WELL COMPLETION DATA:

Dark Clay 175 198

(1) diameter (inches) 2"

Green sand 198 220

(2) total depth (feet) 220

(3) static water level (feet) 100 below above top of ground.

(4) casing Steel, 16"  
(material) (depth)

CODED

\_\_\_\_\_ if telescope see back.  
(size)

(5) screen None  
(length) (depth to top)

\_\_\_\_\_ (size) \_\_\_\_\_ (material)

(6) pump 1" 300  
(HP) (yield gpm)

\_\_\_\_\_ (type power)

(7) electric log \_\_\_\_\_  
(yes or no)

\_\_\_\_\_ (organization running log)

(8) how well bottom plugged \_\_\_\_\_

FEB 12 1969


MISS. BD. OF  
WATER COMMISSIONERS

DRILLERS REMARKS: Open

Bottom

If well telescopes please sketch and show depths.

GROUND LEVEL

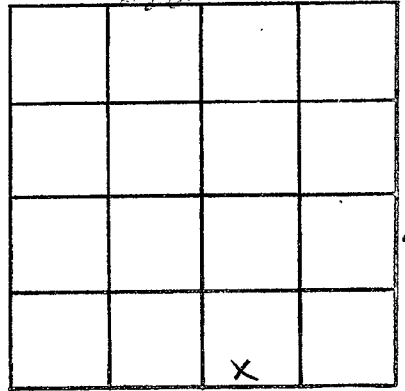

SECTION 15

Please indicate well location X.

ADDITIONAL INFORMATION

If more than one screen, show locations of each on sketch.