

Newton
F 16
4-17-70

MISSISSIPPI
 BOARD OF WATER COMMISSIONERS
 416 North State Street
 Jackson, Mississippi 39201
 WATER WELL DRILLERS LOG

4-17-70 19 McDonald & Hill Newton
 date well completed firm name county well located

LANDOWNER:
Majors Thompson
Rt #3
Decatur, Miss
 (mailing address)

description of formations encountered	from	to
<u>Clay</u>	<u>0</u>	<u>12</u>
<u>Sand</u>	<u>12</u>	<u>70</u>

WELL LOCATION:
 sec. 29 T. 7 N. R. 11 E.
3 miles S. EAST of Decatur
 (distance) (direction) (nearest town)

WELL PURPOSE: Home
 (home, irrigation, municipal, industrial)

- WELL COMPLETION DATA:
- (1) diameter (inches) 2"
 - (2) total depth (feet) 75'
 - (3) static water level (feet) 37 below ~~ground~~
 top of ground.
 - (4) casing Galv, 70'
 (material) (depth)
2"
 (size) if telescope see back.
 - (5) screen 5', 70'
 (length) (depth to top)
2" PVC
 (size) (material)
 - (6) pump 3, 10
 (HP) (yield gpm)
220
 (type power)
 - (7) electric log No.
 (yes or no)
NO
 (organization running log)
 - (8) how well bottom plugged VALUE


MAY 6 1970

MISS. BD. OF
 WATER COMM.

DRILLERS REMARKS:

If well telescopes please
sketch and show depths.

GROUND LEVEL

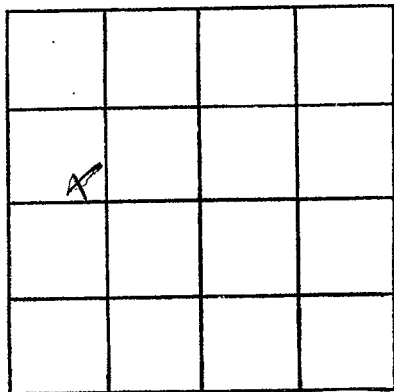

SECTION _____

Please indicate well location X.

ADDITIONAL INFORMATION

If more than one screen,
show locations of each on sketch.