

Newton  
F 17  
10-17-68

MISSISSIPPI  
BOARD OF WATER COMMISSIONERS  
416 North State Street  
Jackson, Mississippi 39201

WATER WELL DRILLERS LOG

10-17-68 date well completed      19 McDonald + Hill firm name      NEWTON county well located

LANDOWNER: BILL ADAMS

DECATUR MISS  
(mailing address)

WELL LOCATION:  
sec. 19 T. 7 S. R. 11 E.  
5 miles WEST of DECATUR  
(distance) (direction) (nearest town)

WELL PURPOSE: HOME  
(home, irrigation, municipal, industrial)

WELL COMPLETION DATA:

- (1) diameter (inches) 4" WELL
- (2) total depth (feet) 350'
- (3) static water level (feet) 100' <sup>below</sup> above top of ground.
- (4) casing BLACK, 273',  
(material) (depth)  
4"  
(size) if telescope see back.
- (5) screen \_\_\_\_\_  
(length) (depth to top)  
\_\_\_\_\_  
(size) (material)
- (6) pump 34 10  
(HP) (yield gpm)  
220  
(type power)
- (7) electric log \_\_\_\_\_  
(yes or no)  
\_\_\_\_\_  
(organization running log)
- (8) how well bottom plugged OPEN

description of formations encountered	from	to
CLAY ST SAND	0	44
SHALE	44	140
SAND	140	230
SOFT SANDY SHALE	230	254
SOFT SHALE	254	270
SHALE	270	306
SANDY ST ROCK	306	330
SAND	330	350


DRILLERS REMARKS:

MAY 4 1970

MISS. Bd. of WATER COMMISSIONERS

If well telescopes please sketch and show depths.

GROUND LEVEL

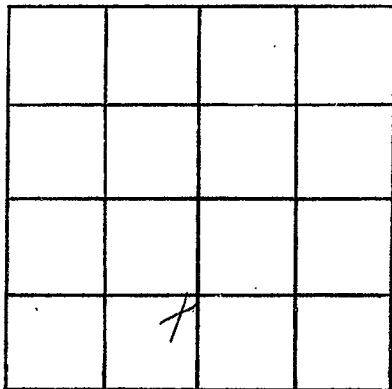

SECTION \_\_\_\_\_

Please indicate well location X.

ADDITIONAL INFORMATION

If more than one screen, show locations of each on sketch.