

Newton
F 18
5-6-70

MISSISSIPPI
 BOARD OF WATER COMMISSIONERS
 416 North State Street
 Jackson, Mississippi 39201

WATER WELL DRILLERS LOG

5-6-70 19 McDONALD + HILL NEWTON
 date well completed firm name county well located

LANDOWNER:
HARLON JONES
DECATUR
 (mailing address)

description of formations encountered	from	to
		0
CLAY SAND	16	48
SAND	48	100

WELL LOCATION:
 sec. 16 T. 7 S. R. 11 E 008
2 miles EAST of DECATUR
 (distance) (direction) (nearest town)

WELL PURPOSE: HOM
 (home, irrigation, municipal, industrial)


- WELL COMPLETION DATA:
- (1) diameter (inches) 2"
 - (2) total depth (feet) 100'
 - (3) static water level (feet) 55' below top of ground.
 - (4) casing GALV. 95'
 (material) (depth)
2" if telescope see back.
 (size)
 - (5) screen 5' 95'
 (length) (depth to top)
24 PVC
 (size) (material)
 - (6) pump 3/4 10
 (HP) (yield gpm)
220
 (type power)
 - (7) electric log NO
 (yes or no)
NO
 (organization running log)
 - (8) how well bottom plugged VALVE

DRILLERS REMARKS:

MAY 11 1970
 MISS. BD. OF
 WATER COMM.

If well telescopes please sketch and show depths.

GROUND LEVEL

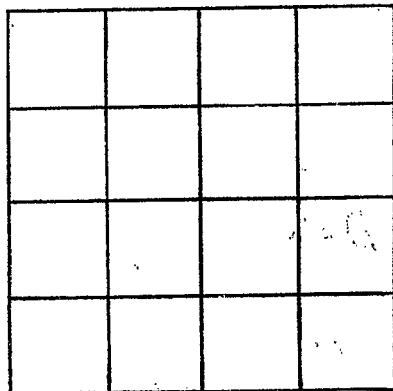

SECTION _____

Please indicate well location X.

ADDITIONAL INFORMATION

If more than one screen,
show locations of each on sketch.