

NEWTON

F 20

1-29-71

MISSISSIPPI
 BOARD OF WATER COMMISSIONERS
 416 North State Street
 Jackson, Mississippi 39201

CODED

WATER WELL DRILLERS LOG

Jan 29 1971
date well completed

McDonald Hill Inc
firm name

Newton
county well located

LANDOWNER: George Vaughn

Rt # 3

Decatur, Miss
(mailing address)

WELL LOCATION:

sec. 31 T. 7 N. R. 11 E. S. 5 W.
8 miles west of Decatur
 (distance) (direction) (nearest town)

WELL PURPOSE: home
(home, irrigation, municipal, industrial)

WELL COMPLETION DATA:

- (1) diameter (inches) 2
- (2) total depth (feet) 190
- (3) static water level (feet) 123 below top of ground
- (4) casing 2" standard (material) 185' (depth)
- no (size) if telescope see back.
- (5) screen 5' (length) 185' (depth to top)
- 3" (size) plastic (material)
- (6) pump 1 (HP) 10 (yield gpm)
- jet (type/power)
- (7) electric log no (yes or no)
- no (organization running log)
- (8) how well bottom plugged Back pressure valve

description of formations encountered

from

to

clay	0	12
sand	12	25
shale	25	50
sandy sh shale	50	83
sandy shale	83	100
shale	100	150
fine sandy shale	150	178
coarse sand	178	190

CODED


FEB 4 1971

MISS. Bd. OF WATER COMMISSIONERS

DRILLERS REMARKS: none

If well telescopes please sketch and show depths.

GROUND LEVEL

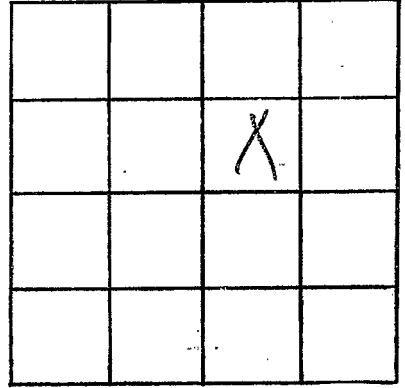

SECTION 31

Please indicate well location X.

ADDITIONAL INFORMATION

If more than one screen,
show locations of each on sketch.