

MISSISSIPPI
 BOARD OF WATER COMMISSIONERS
 416 North State Street
 Jackson, Mississippi 39201

CODED

NEWTON
F21
4-26-71

WATER WELL DRILLERS LOG

4-26 1971 McDonald Hilltop Newton
 date well completed firm name county well located

LANDOWNER: Vernon Reeves

Decatur, Miss

(mailing address)

WELL LOCATION:

sec. 2 T. 7 N. R. 11 E.
 S. W.
3 miles North of Decatur
 (distance) (direction) (nearest town)

WELL PURPOSE: home
 (home, irrigation, municipal, industrial)

WELL COMPLETION DATA:

- (1) diameter (inches) 2
- (2) total depth (feet) 46
- (3) static water level (feet) 32 below above top of ground.
- (4) casing 2" galv 40
 (material) (depth)
- no if telescope see back.
 (size)
- (5) screen 5 41
 (length) (depth to top)
- 2 plastic
 (size) (material)
- (6) pump 1 10
 (HP) (yield gpm)
- jet
 (type power)
- (7) electric log no
 (yes or no)

(organization running log)

(8) how well bottom plugged back
pressure valve

DRILLERS REMARKS: none

description of formations encountered	from	to
<u>Clay</u>	<u>0</u>	<u>12</u>
<u>Coarse Sand</u>	<u>12</u>	<u>46</u>


CODED

APR 30 - 1971

MISS. Bd. OF WATER COMM.

If well telescopes please sketch and show depths.

GROUND LEVEL

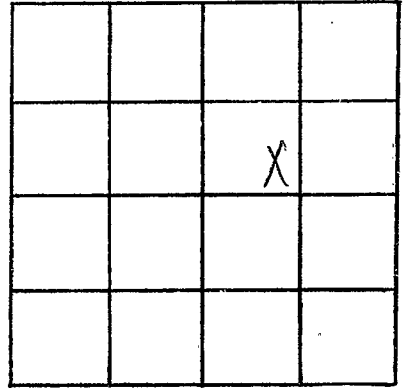

SECTION 2

Please indicate well location X.

ADDITIONAL INFORMATION

If more than one screen,
show locations of each on sketch.