

NEWTON

F22

4-27-71

MISSISSIPPI
 BOARD OF WATER COMMISSIONERS
 416 North State Street
 Jackson, Mississippi 39201

CODED

WATER WELL DRILLERS LOG

4-27 1971
date well completed

McDonald Hill Inc
firm name

Newton
county well located

LANDOWNER: James Cleveland

Rt # 3

Decatur, Miss
(mailing address)

WELL LOCATION:

sec. 20 T. 7 N. R. 11 E. S. W.

5 miles Northwest of Decatur
(distance) (direction) (nearest town)

WELL PURPOSE: home
(home, irrigation, municipal, industrial)

WELL COMPLETION DATA:

- (1) diameter (inches) 2
- (2) total depth (feet) 220
- (3) static water level (feet) 150 below top of ground.
- (4) casing 2" Plug + Rem (material), 215 (depth)
- (size) m if telescope see back.
- (5) screen 5 (length), 215 (depth to top)
- 2" (size), Plastic (material)
- (6) pump 1 (HP), 10 (yield gpm)
- ret (type (power))
- (7) electric log no (yes or no)

(organization running log)

(8) how well bottom plugged back
pressure valve

DRILLERS REMARKS: none

description of formations encountered

from

to

sand

0 20

Clay + sand	20	40
st Rock + shale	40	50
st green sand	50	90
shale	90	110
st shale	110	120
st Shells	120	130
shale	130	200
Coarse sand	200	220


CODED

MAY 3 - 1971

MISS. BD. OF
WATER COMMISSIONERS

If well telescopes please sketch and show depths.

GROUND LEVEL

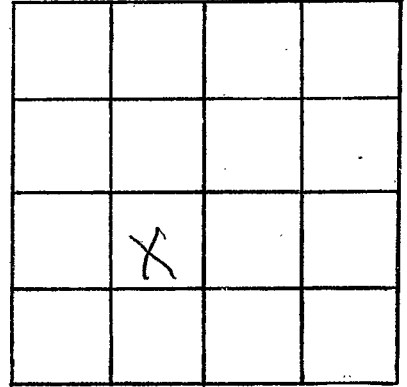

SECTION 20

Please indicate well location X.

ADDITIONAL INFORMATION

If more than one screen,
show locations of each on sketch.