

NEWTON
F23
7-71

MISSISSIPPI
BOARD OF WATER COMMISSIONERS
416 North State Street
Jackson, Mississippi 39201

CODED

WATER WELL DRILLERS LOG

7 1971 McDonald & Hill Inc Newton
date well completed firm name county well located

LANDOWNER: Zack Wilson
Rt 3
Decatur, Miss
(mailing address)

WELL LOCATION:
sec 34 T 7 N R 11 E
5 miles southwest of Decatur
(distance) (direction) (nearest town)

WELL PURPOSE: home
(home, irrigation, municipal, industrial)

WELL COMPLETION DATA:

- (1) diameter (inches) 7
- (2) total depth (feet) 180
- (3) static water level (feet) 125 below top of ground.
- (4) casing Short pipe 175
(material) (depth)
- (size) if telescope see back.
- (5) screen 5 175
(length) (depth to top)
- (size) (material) 2 Plastic
- (6) pump 1 10
(HP) (yield gpm)
- (type power) sit
- (7) electric log no
(yes or no)
- (organization running log) no
- (8) how well bottom plugged back
measure cable

description of formations encountered	from	to
	Clay shale	0
sandy clay & sand	16	26
sand	36	100
st coke sand	40	52
sand	54	60
sand	60	75
shale	75	85
st coke sand	85	90
shale	90	142
st coke sand	112	128
st coke sand	138	150
st coke sand	150	180


CODED

JUN 25 1971
MISS. Bd. OF WATER CONTROL

DRILLERS REMARKS: none

If well telescopes please
sketch and show depths.

GROUND LEVEL

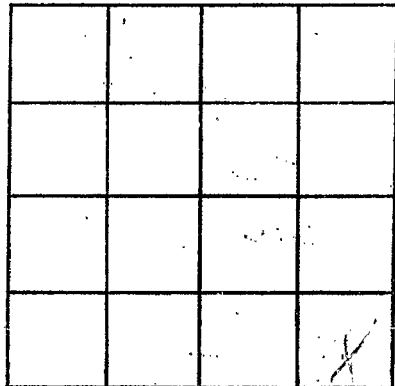

SECTION 34

Please indicate well location X.

ADDITIONAL INFORMATION

If more than one screen,
show locations of each on sketch.