

Newton
F-24
8-16-71

MISSISSIPPI
 BOARD OF WATER COMMISSIONERS
 416 North State Street
 Jackson, Mississippi 39201

CODED

WATER WELL DRILLERS LOG

8-16 1971 U. L. Shelch Newton
 date well completed firm name county well located

LANDOWNER: E. B. Stamps
Orester
Miss
 (mailing address)

description of formations encountered	from	to
<u>yellow clay</u>	<u>0</u>	<u>20</u>
<u>Sand</u>	<u>20</u>	<u>95</u>
<u>clay</u>	<u>95</u>	<u>130</u>
<u>rocky</u>	<u>130</u>	<u>160</u>
<u>shell</u>	<u>160</u>	<u>185</u>
<u>Sand</u>	<u>185</u>	<u>200</u>

WELL LOCATION:
 sec. 11 T. 7 N. R. 16 E.
3 miles NW of Orester
 (distance) (direction) (nearest town)

WELL PURPOSE: Home
 (home, irrigation, municipal, industrial)

WELL COMPLETION DATA:
 (1) diameter (inches) 2"
 (2) total depth (feet) 200
 (3) static water level (feet) 23 below above top of ground.
 (4) casing gal steel 126
 (material) (depth)

CODED

_____ if telescope see back.
 (size) _____
Open hole
 (a) screen (length) (depth to top)

_____ (size) _____ (material)

(6) pump _____ (HP) _____ (yield gpm)

_____ (type power)

(7) electric log _____ (yes or no)

_____ (organization running log)

(8) how well bottom plugged _____


SEP 14 1971

MISS. Bd. OF WATER COM.

DRILLERS REMARKS: Mr. Stamps installed the pump himself

If well telescopes please sketch and show depths.

GROUND LEVEL

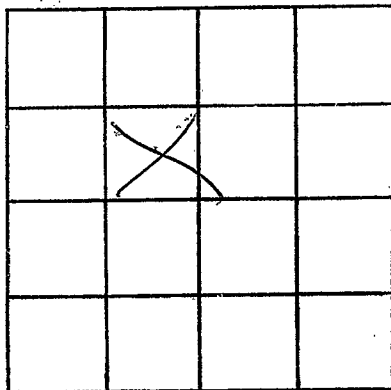

SECTION _____

Please indicate well location X.

ADDITIONAL INFORMATION

If more than one screen,
show locations of each on sketch.