

Newton
F26
6-8-72

MISSISSIPPI
 BOARD OF WATER COMMISSIONERS
 416 North State Street
 Jackson, Mississippi 39201

CODED

WATER WELL DRILLERS LOG

6-8 19**72** **W. H. Shelton** **Newton**
 date well completed firm name county well located

LANDOWNER: J. H. Blount	description of formations encountered	from	to
Desatur Miss (mailing address)			
WELL LOCATION: sec. 11 T. 7 N. R. 11 E. 3 miles NW of Desatur (distance) (direction) (nearest town)	Yellow Clay 0 16		
WELL PURPOSE: Frame (home, irrigation, municipal, industrial)	Sandy Brown 16 40		
WELL COMPLETION DATA: (1) diameter (inches) 2"	Brackish 40 60		
(2) total depth (feet) 220	Sand 60 90		
(3) static water level (feet) 58 below above top of ground.	Dark Brown 90 100		
(4) casing Galv Steel (material) (depth)	Shell 100 120		
(size) If telescope see back.	Dark Brown Shell 120 174		
(5) screen Open Hole (length) (depth to top)	Sandy 174 195		
(size) (material)	Rocky 195 200		
(6) pump _____ (HP) (yield gpm)	Sand 200 220		
(type power)			
(7) electric log (yes or no) _____			
(organization running log) _____			
(8) how well bottom plugged _____			
DRILLERS REMARKS: Mr. Blount installed his pump him self later			


CODED

MISS. BD. OF WATER COMMISSIONERS

MISS. BD. OF WATER COMMISSIONERS

If well telescopes please sketch and show depths.

GROUND LEVEL

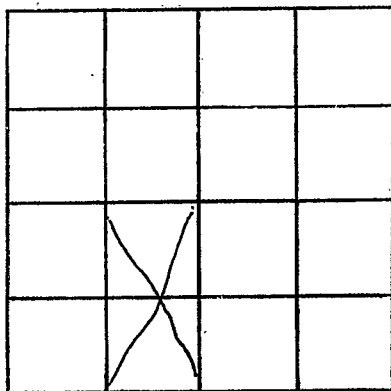

SECTION _____

Please indicate well location X.

ADDITIONAL INFORMATION

If more than one screen,
show locations of each on sketch.