

Newton
F 27

MISSISSIPPI
BOARD OF WATER COMMISSIONERS
416 North State Street
Jackson, Mississippi 39201

CODED

4. 19. 73

WATER WELL DRILLERS LOG

19 McDONALD + HILL firm name NEWTON county well located
date well completed

LANDOWNER:
KENNY McMULLEN
R#1 DECATOR
(mailing address)

description of formations encountered
CLAY from 0 to 12

WELL LOCATION:
sec. 16 T. 7 N. R. 11 E.
1 miles NEAST of DECATOR
(distance) (direction) (nearest town)

SAND 12 37
SHALE 37 66
ROCK ST. SHELLS 66 85

WELL PURPOSE: HOME
(home, irrigation, municipal, industrial)

R SAND 85 90
ROCK SHALE 90 105

WELL COMPLETION DATA:
(1) diameter (inches) 4 1/2
(2) total depth (feet) _____
(3) static water level (feet) 80' below top of ground.
(4) casing PVC 63'
(material) (depth)
4 1/2 if telescope see back.
(size)
(5) screen _____
(length) (depth to top)
(size) (material)
(6) pump 1/2 10
(HP) (yield gpm)
220
(type power)
(7) electric log _____
(yes or no)
(organization running log) _____
(8) how well bottom plugged OPEN


SAND 105 118
ROCK SHALE 118 230
SAND 230 290

CODED

DRILLERS REMARKS:

If well telescopes please sketch and show depths.

GROUND LEVEL

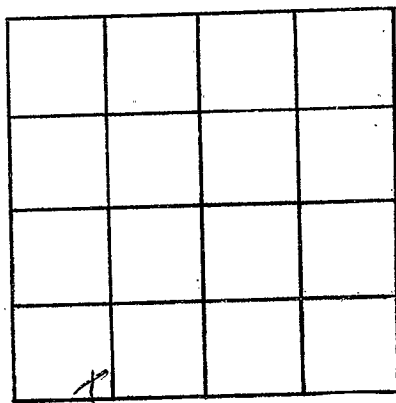

SECTION _____

Please indicate well location X.

ADDITIONAL INFORMATION

If more than one screen, show locations of each on sketch.