

F 32
 NEWTON
 8-8-73

MISSISSIPPI
 BOARD OF WATER COMMISSIONERS
 416 North State Street
 Jackson, Mississippi 39201

CODED

WATER WELL DRILLERS LOG

8. 8. 73 date well completed McDonald + Hill firm name Newton county well located


LANDOWNER:	description of formations encountered	from	to
DAVE ETHRIDGE	CLAY	0	12
R#1 DECATUR (mailing address)	CLAY ST SAND	12	40
WELL LOCATION: sec. 23 T 2 N R 11 E S W	SHALE	40	60
1 miles WEST of DECATUR (distance) (direction) (nearest town)	SANDY	60	90
WELL PURPOSE: <u>HOUSE</u> (home, irrigation, municipal, industrial)	SHALE	90	110
WELL COMPLETION DATA:	SAND	110	150
(1) diameter (inches) <u>4"</u>	SANDY	150	160
(2) total depth (feet) <u>260</u>	SHALE	160	185
(3) static water level (feet) <u>130'</u> below top of ground.	ROCK ST SAND	185	200
(4) casing <u>PVC</u> <u>178'</u> (material) (depth)	SAND ST ROCK	200	240
<u>4"</u> (size) if telescope see back.	SANDY	240	260
(5) screen _____ (length) (depth to top)			
(size) _____ (material)			
(6) pump <u>34</u> <u>10</u> (HP) (yield gpm)			
<u>ELECTRIC</u> (type power)			
(7) electric log _____ (yes or no)			
(organization running log)			
(8) how well bottom plugged <u>OPEN</u>			
DRILLERS REMARKS:			

AUG 14 1973

SET pump 160

If well telescopes please sketch and show depths.

GROUND LEVEL

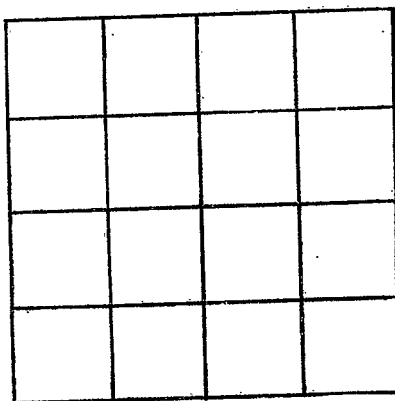

SECTION _____

Please indicate well location X.

ADDITIONAL INFORMATION

If more than one screen, show locations of each on sketch.