

**NEWTON**  
**F33**  
**11-26-73**

MISSISSIPPI  
 BOARD OF WATER COMMISSIONERS  
 416 North State Street  
 Jackson, Mississippi 39201 **CODED**

**WATER WELL DRILLERS LOG**

11.26.73 McDONALD + Hill NEWTON  
 date well completed firm name county well located

**LANDOWNER:**  
WADELL MAPP  
PHIL DECATUR  
 (mailing address)

**WELL LOCATION:**  
 sec. 35 T. 7 N. R. 11 E.  
2 miles SWEST DECATUR  
 (distance) (direction) (nearest town)

description of formations encountered	from	to
CLAY ST SAND	0	15
SHALE	15	45
SAND	45	50
SHALE	50	108
SAND	108	120
SAND	120	130
FINE SAND LENTH	130	148
COURSE SAND	148	160

**WELL PURPOSE:** HOME  
 (home, irrigation, municipal, industrial)

- WELL COMPLETION DATA:**
- (1) diameter (inches) 2 1/2
  - (2) total depth (feet) 160
  - (3) static water level (feet) 88 below above top of ground.
  - (4) casing PVC 150'  
 (material) (depth)  
2 1/2 if telescope see back.  
 (size)
  - (5) screen 8' 150'  
 (length) (depth to top)  
2 1/2 PVC  
 (type power)
  - (7) electric log \_\_\_\_\_  
 (yes or no)  
 \_\_\_\_\_  
 (organization running log)
  - (8) how well bottom plugged VALVE


**CODED**

**DRILLERS REMARKS:**  
1 1/2" CYLINDER

NOV 29 1973

If well telescopes please sketch and show depths.

GROUND LEVEL

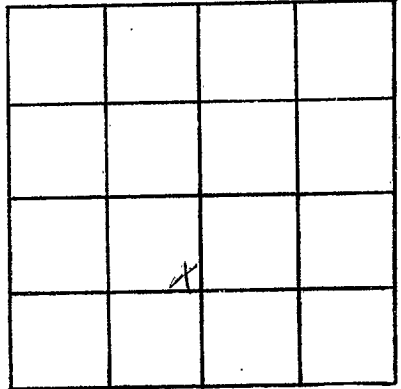

SECTION \_\_\_\_\_

Please indicate well location X.

ADDITIONAL INFORMATION

If more than one screen, show locations of each on sketch.