

NEWTON

F34

7-25-74

MISSISSIPPI
 BOARD OF WATER COMMISSIONERS
 416 North State Street
 Jackson, Mississippi 39201

CODED

WATER WELL DRILLERS LOG

2.25.74
date well completed

19 McDONALD + HILL
firm name

Newton
county well located

LANDOWNER:

H.P. BURTON
Rt 1 DECATOR
(mailing address)

description of formations encountered

CLAY
SAND

from 2 18
to 78 70

WELL LOCATION:

sec. 11 T. 7^N R. 11^E
2 miles N. WEST of DECATOR
(distance) (direction) (nearest town)


WELL PURPOSE:

(home, irrigation, municipal, industrial)

WELL COMPLETION DATA:

- (1) diameter (inches) 2 1/2
- (2) total depth (feet) 70'
- (3) static water level (feet) 37' below top of ground.
- (4) casing PVC 64' (material) (depth)
2 1/2 (size) if telescope see back.
- (5) screen 5' 64' (length) (depth to top)
2 1/2 (size) PVC (material)
- (6) pump 1/2 JET 6 (HP) (yield gpm)
ELECTRIC (type power)
- (7) electric log (yes or no)

CODED

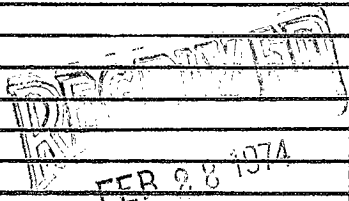

MISS. BO. OF WATER COMMISSIONERS

(organization running log)

(8) how well bottom plugged VALVE

DRILLERS REMARKS:

