

MISSISSIPPI
BOARD OF WATER COMMISSIONERS
416 North State Street
Jackson, Mississippi 39201

CODED

NEWTON
F 35
3-22-74

WATER WELL DRILLERS LOG

3.22.74 date well completed
McDonald + Hill firm name
NEWTON county well located

LANDOWNER:

JERRY SMITH

R#1 DECATUR

(mailing address)

WELL LOCATION:

sec. 13 T. 7 N R. 11 E
2 miles NORTH of DECATUR
(distance) (direction) (nearest town)

WELL PURPOSE:

(home, irrigation, municipal, industrial)

WELL COMPLETION DATA:

- (1) diameter (inches) 4"
- (2) total depth (feet) 180'
- (3) static water level (feet) 40' below above top of ground.
- (4) casing PVC 115' (material) (depth)
4" (size) if telescope see back.
- (5) screen (length) (depth to top)
(size) (material)
- (6) pump 1/2 sub 10 (HP) (yield gpm)
E (type power)
- (7) electric log (yes or no)
(organization running log)
- (8) how well bottom plugged OPEN

description of formations encountered

from to

CLAY	0	10
SAND	10	37
SHALE	37	70
SAND	70	95
SHALE	95	118
ROCK SHALE	118	140
GREEN SAND	140	180

CODED


DRILLERS REMARKS:

RECEIVED
MAR 27 1974

MISS. RD. OF WATER COMMISSIONERS

If well telescopes please
sketch and show depths.

GROUND LEVEL

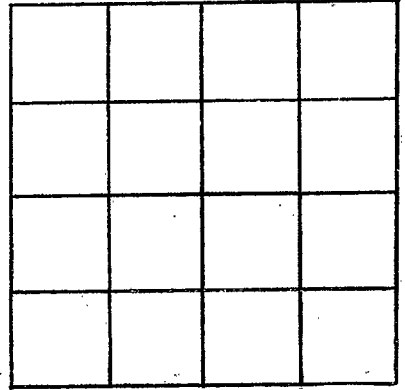

SECTION _____

Please indicate well location X.

ADDITIONAL INFORMATION

If more than one screen,
show locations of each on sketch.