

NEWTON

~~LANDERDALE~~
F36
8-13-74

MISSISSIPPI
BOARD OF WATER COMMISSIONERS
416 North State Street
Jackson, Mississippi 39201

CODED

WATER WELL DRILLERS LOG **NEWTON**

8, 13, 74 date well completed
McDONALD & HILL firm name
~~LANDERDALE~~ county well located

LANDOWNER:	description of formations encountered	from	to
GARLAND JEFF COAT	CLAY	0	20
R#1 DECATUR (mailing address)	SHALE ST SAND	20	40
WELL LOCATION: sec. 19 T 70N R 11E S W 1/2 miles WEST DECATUR (distance) (direction) (nearest town)	SAND ST CLAY	40	80
WELL PURPOSE: (home, irrigation, municipal, industrial)	SHALE	80	120
WELL COMPLETION DATA:	SAND	120	205
(1) diameter (inches) 4"	SAND	205	220
(2) total depth (feet) 320'	SHALE	220	262
(3) static water level (feet) 150' below top of ground.	SAND ST ROCK	262	320
(4) casing PVC 238' (material) (depth) 4" (size) if telescope see back.	CODED		
(5) screen (length) (depth to top) (size) (material)			
(6) pump 1 sub 6 (HP) (yield gpm) E (type power)			
(7) electric log (yes or no) (organization running log)			
(8) how well bottom plugged OPEN			
DRILLERS REMARKS:			


RECEIVED

AUG 19 1974

R GUMM

If well telescopes please sketch and show depths.

GROUND LEVEL

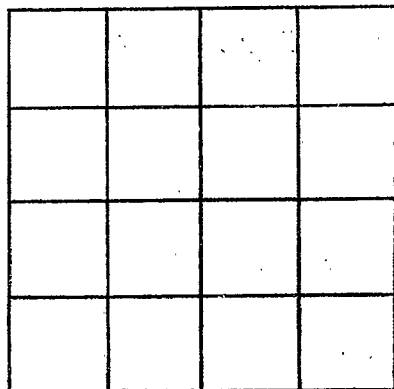

SECTION _____

Please indicate well location X.

ADDITIONAL INFORMATION

If more than one screen,
show locations of each on sketch.