

NEWTON
F37
8-14-74

MISSISSIPPI
BOARD OF WATER COMMISSIONERS
416 North State Street
Jackson, Mississippi 39201

CODED

WATER WELL DRILLERS LOG

8.14.74 19 McDonald + Hill NEWTON
date well completed firm name county well located

LANDOWNER:
HARSTON HEFLINE
R#1 DECATUR
(mailing address)

description of formations encountered	from	to
Clay & sand	0	24
Sand & Clay	24	80
Shale	80	125
Sand	125	220
Sandy	220	235
Shale	235	294
Rock & Shale	294	315
Sand & Shale	315	350

WELL LOCATION:
sec. 16 T 70 N R 11 E
3 miles WEST of DECATUR
(distance) (direction) (nearest town)

WELL PURPOSE: HOME
(home irrigation, municipal, industrial)

WELL COMPLETION DATA:

(1) diameter (inches) 4"

(2) total depth (feet) 350'

(3) static water level (feet) 170' below top of ground. #40

(4) casing PVC 270' (material) (depth)
4" (size) if telescope see back.

(5) screen (length) (depth to top)
(size) (material)

(6) pump 1/2 Sub 6 (HP) (yield gpm)
E (type power)

(7) electric log (yes or no)
(organization running log)

(8) how well bottom plugged OPEN

CODED

RECEIVED


AUG 19 1974

DRILLERS REMARKS:
SET pump 220'

WATER COMM

If well telescopes please sketch and show depths.

GROUND LEVEL

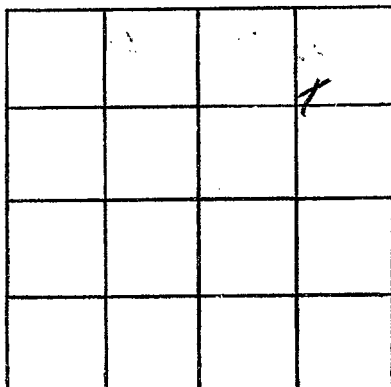

SECTION _____

Please indicate well location X.

ADDITIONAL INFORMATION

If more than one screen, show locations of each on sketch.