

NEWTON

F38

9-19-74

MISSISSIPPI
 BOARD OF WATER COMMISSIONERS
 416 North State Street
 Jackson, Mississippi 39201

WATER WELL DRILLERS LOG **CODED**

9-19-74

date well completed:

McDONALD + HILL

firm name

NEWTON

county well located

LANDOWNER:

DONNIE HARRIS

R#1 DECATUR

(mailing address)

description of formations encountered

Clay

from

to

0

65

SHALE

65

80

WELL LOCATION:

sec 16 T 7 N R 16 E

7 miles NORTH of Newton
(distance) (direction) (nearest town)

SHALE ST. ROCK

80

115

SHALE

115

210

SAND

210

325

WELL PURPOSE:

(home, irrigation, municipal, industrial)

SOFT SAND

325

355

WELL COMPLETION DATA:

- (1) diameter (inches) 4"
- (2) total depth (feet) 450'
- (3) static water level (feet) 180' below top of ground

- (4) casing PVC 362' (material) (depth)

4" if telescope see back. (size)

- (5) screen (length) (depth to top)

(size) (material)

- (6) pump 34 0 (HP) (yield gpm)

E (type power)

- (7) electric log (yes or no)

(organization running log)

- (8) how well bottom plugged OPEN

DRILLERS REMARKS:


REGISTERED
RIS

SEP 30 1974

MISS. BD. OF WATER COMMISSIONERS

If well telescopes please sketch and show depths.

GROUND LEVEL

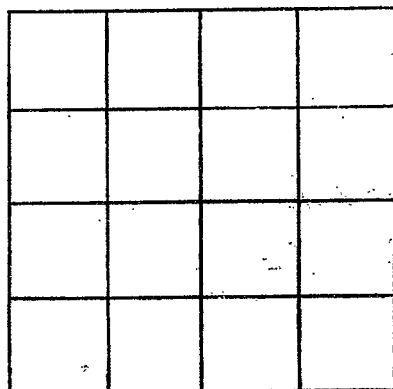

SECTION _____

Please indicate well location X.

ADDITIONAL INFORMATION

If more than one screen,
show locations of each on sketch.