

**NEWTON**  
**F 39**  
**10-29-74**

**MISSISSIPPI**  
**BOARD OF WATER COMMISSIONERS**  
 416 North State Street  
 Jackson, Mississippi 39201

**WATER WELL DRILLERS LOG**

10.29.74 19 McDONALD & WILK NEWTON  
 date well completed firm name county well located

**LANDOWNER:**

COSTELLA TOWNER

**description of fomations encountered**

Clay St sand

**from**

**to**

0 16

R#1 DECATUR

(mailing address)

Shale

16 50

**WELL LOCATION:**

sec. 21 T. 7 N. R. 11 E.  
4 miles WEST of DECATUR  
 (distance) (direction) (nearest town)

SHELLS ST SAND

50 65

SHALE

65 124

SAND

124 200

**WELL PURPOSE:**

HOME  
 (home, irrigation, municipal, industrial)

SANDY

200 235

**WELL COMPLETION DATA:**

- (1) diameter (inches) 4"
- (2) total depth (feet) 340'
- (3) static water level (feet) 180' below top of ground.
- (4) casing PVC, 252,  
 (material) (depth)  
4"  
 (size) if telescope see back.
- (5) screen \_\_\_\_\_  
 (length) (depth to top)  
 \_\_\_\_\_  
 (size) (material)
- (6) pump 34 6  
 (HP) (yield gpm)  
ELECTRIC  
 (type power)
- (7) electric log \_\_\_\_\_  
 (yes or no)  
 \_\_\_\_\_  
 (organization running log)
- (8) how well bottom plugged OPEN


**DECATUR**  
 MISSISSIPPI  
 NOV - 4 1974

**DRILLERS REMARKS:**

**BD. OF WATER COM.**

If well telescopes please sketch and show depths.

GROUND LEVEL

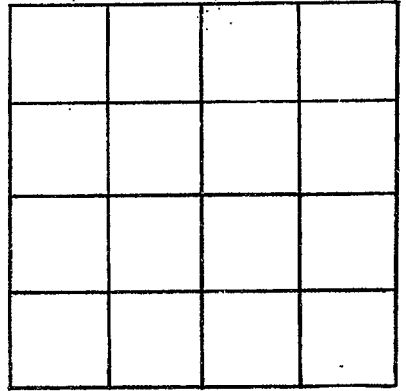

SECTION \_\_\_\_\_

Please indicate well location X.

ADDITIONAL INFORMATION

If more than one screen,  
show locations of each on sketch.