

F 41  
 Newton  
 5/20/75

MISSISSIPPI  
 BOARD OF WATER COMMISSIONERS  
 416 North State Street  
 Jackson, Mississippi 39201

CODED

WATER WELL DRILLERS LOG


5.20.75 date well completed  
 McDONALD + HILL firm name  
 NEWTON county well located

LANDOWNER:	description of formations encountered	from	to
Miss. Forestry Com. Newton, Miss (mailing address)			
	CLAY SAND	7	6
	CLAY	10	28
	SHALE	28	85
WELL LOCATION: sec. 31 T. 7 N. R. 11 E 2 miles N of Newton (distance) (direction) (nearest town)	SAND	85	190
	SAND ST SHALE	190	235
WELL PURPOSE: (home, irrigation, municipal, industrial)	SANDY ST SHALE	235	270
WELL COMPLETION DATA:	SHALE	270	308
(1) diameter (inches) 4"	ROCK ST SHELLS	308	330
(2) total depth (feet) 360'	GREEN SAND	330	345
(3) static water level (feet) 150' below top of ground.	SANDY	345	360
(4) casing PVC 274' SCH 40 (material) (depth) 4" if telescope see back. (size)			
(5) screen (length) (depth to top) (size) (material)			
(6) pump 1 sub 10 (HP) (yield gpm) ELECTRIC (type power)			
(7) electric log (yes or no) (organization running log)			
(8) how well bottom plugged. OPEN			
DRILLERS REMARKS:			

DECEMBER 1975  
 MAY 27 1975  
 MISS. BOARD OF WATER COMMISSIONERS

If well telescopes please sketch and show depths.

GROUND LEVEL

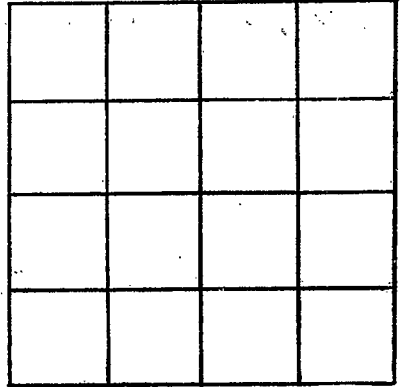

SECTION \_\_\_\_\_

Please indicate well location X.

ADDITIONAL INFORMATION

If more than one screen,  
show locations of each on sketch.