

Newton
E 42
8-14-75

MISSISSIPPI
BOARD OF WATER COMMISSIONERS
416 North State Street
Jackson, Mississippi 39201

CODED

WATER WELL DRILLERS LOG

8.14.75 19 McDonald + Hill NEWTON
date well completed firm name county well located

LANDOWNER:
I. B. ROBINSON
Rt 1 Conchata Miss
(mailing address)


description of formations encountered	from	to
Clay sand	0	25
Clay	25	98
Shale	98	165
Sand	165	365
Shale	365	418
Sand shale to rock	418	480

WELL LOCATION:
sec. 31 T. 8N R. 7E 13T
7 miles SW of DECATUR
(distance) (direction) (nearest town)

WELL PURPOSE:
(home, irrigation, municipal, industrial)

- WELL COMPLETION DATA:
- (1) diameter (inches) 4"
 - (2) total depth (feet) 485'
 - (3) static water level (feet) 155' below top of ground.
 - (4) casing PVC 380' (material) (depth)
4" (size) if telescope see back.
 - (5) screen (length) (depth to top)
(size) (material)
 - (6) pump 1 (HP) 6 (yield gpm)
E (type power)
 - (7) electric log (yes or no)
(organization running log)
 - (8) how well bottom plugged OPEN

CODED

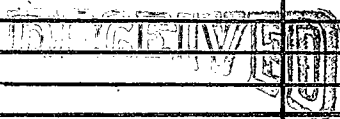


AUG 18 1975

DRILLERS REMARKS:

If well telescopes please sketch and show depths.

GROUND LEVEL

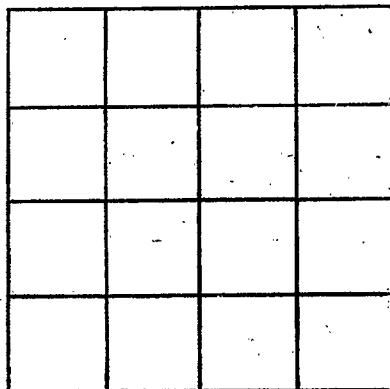

SECTION _____

Please indicate well location X.

ADDITIONAL INFORMATION

If more than one screen,
show locations of each on sketch.