

Newton
F 43
10-18-75

MISSISSIPPI
 BOARD OF WATER COMMISSIONERS
 416 North State Street
 Jackson, Mississippi 39201

WATER WELL DRILLERS LOG


10-18-75 ¹³⁰ MCDONALD + WEL NEWTON
 date well completed firm name county well located

LANDOWNER:	description of formations encountered	from	to
<u>HOMER L McELHENNY</u>			
<u>R#2 DECATOR</u> (mailing address)	<u>Shale</u>	<u>38</u>	<u>103</u>
WELL LOCATION:	<u>Sand shale</u>	<u>103</u>	<u>135</u>
sec <u>23T. 7N S</u> R <u>10E</u>	<u>Brown shale</u>	<u>135</u>	<u>158</u>
<u>2</u> miles <u>WEST</u> of <u>DECATOR</u> (distance) (direction) (nearest town)	<u>Sand</u>	<u>158</u>	<u>178</u>
WELL PURPOSE: <u>HOME</u> (home, irrigation, municipal, industrial)	<u>Sand</u>	<u>178</u>	<u>248</u>
WELL COMPLETION DATA:	<u>Shale</u>	<u>248</u>	<u>290</u>
(1) diameter (inches) <u>4"</u>	<u>Sand</u>	<u>290</u>	<u>330</u>
(2) total depth (feet) <u>330'</u>			
(3) static water level (feet) <u>180'</u> ^{below} _{above} top of ground.			
(4) casing <u>PVC</u> <u>252'</u> (material) (depth)			
<u>4"</u> (size) If telescope see back.			
(5) screen _____ (length) (depth to top)			
(size) _____ (material) _____			
(6) pump <u>1</u> <u>6</u> (HP) (yield gpm)			
<u>E</u> (type power)			
(7) electric log _____ (yes or no)			
(organization running log) _____			
(8) how well bottom plugged <u>OPEN</u>			
DRILLERS REMARKS:			

RECEIVED
 OCT 27 1975
 MISS. Bd. OF WATER COMMISSIONERS

If well telescopes please sketch and show depths.

GROUND LEVEL

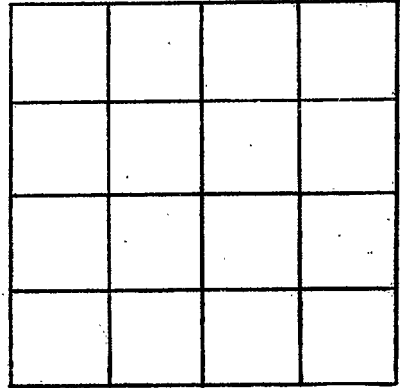

SECTION _____

Please indicate well location X.

ADDITIONAL INFORMATION

If more than one screen, show locations of each on sketch.