

Newton
F 44
10-20-75

MISSISSIPPI
BOARD OF WATER COMMISSIONERS
416 North State Street
Jackson, Mississippi 39201

WATER WELL DRILLERS LOG

10-20-75 ^{13T} 19 McDonald & Hill NEWTON
date well completed firm name county well located

LANDOWNER:
ELMER JORDAN
RTE 1 DECATUR
(mailing address)


WELL LOCATION:
sec 18 T 7 N R 11 E
S W
2.45 miles SOUTHWEST of DECATUR
(distance) (direction) (nearest town)

WELL PURPOSE: FOUNTAIN
(home, irrigation, municipal, industrial)

- WELL COMPLETION DATA:
- (1) diameter (inches) 4 1/2
 - (2) total depth (feet) 280'
 - (3) static water level (feet) 155' below top of ground.
 - (4) casing PVC 2 1/2" (material) (depth)
4" if telescope see back. (size)
 - (5) screen (length) (depth to top)
(size) (material)
 - (6) pump 1/2 sub 5 (HP) (yield gpm)
E (type power)
 - (7) electric log (yes or no)
 - (organization running log)
 - (8) how well bottom plugged OPEN


description of formations encountered	from	to
Clay Sand	0	18'
Shale	18	108'
Sand & Shale	108	140
Sand	140	198
Light Shale	190	205
Shale	205	248
Sand & Shale	248	280

DRILLERS REMARKS:
SET PUMP 300'

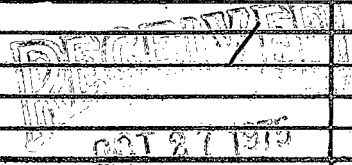

If well telescopes please sketch and show depths.

GROUND LEVEL

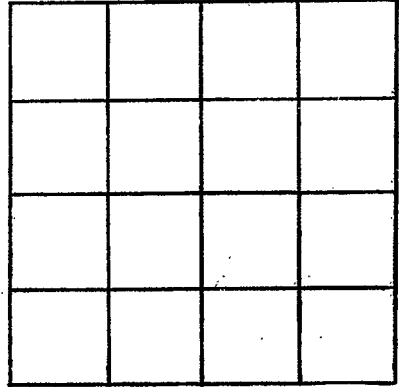

SECTION _____

Please indicate well location X.

ADDITIONAL INFORMATION

If more than one screen, show locations of each on sketch.