

MISSISSIPPI DEPARTMENT OF NATURAL RESOURCES

Bureau of Land and Water Resources

Southport Mall

P.O. Box 10631

Jackson, Mississippi 39209

WATER WELL DRILLERS LOG

Department of Natural Resources  
Bureau of Land & Water Resources  
county well located

F 51  
NEWTON Co.  
3/85

CODED

RECEIVED

MAR 18 1985

3  
1985  
date well completed

McDonald & Hill Inc.  
firm name

LANDOWNER: Ronald Davis  
Rt # 1  
Decatur, MS  
(mailing address)

WELL LOCATION:  
sec. 10 T. 7 N. R. 11 E.  
5 miles N.W. of Decatur  
(distance) (direction) (nearest town)

WELL PURPOSE: home  
(home, irrigation, municipal, industrial)

WELL COMPLETION DATA:

(1) diameter (inches) 4"

(2) total depth (feet) 320

(3) static water level (feet) 175 below top of ground.

(4) casing 4" PVC 262'  
(material) (depth)

(size) if telescope see back.

(5) screen (length) (depth to top)  
(size) (material)

(6) pump (HP) 10 (yield gpm)  
(type power)

(7) electric log (yes or no)  
(organization running log)


(8) how well bottom plugged

description of formations encountered	from	to
Clay & sand	0	20
Shale st clay	20	30
Shale sandy st	30	80
Shale	80	100
Brown shale st sand	100	175
Shale st sand	175	236
hard shell	236	275
Sandy st Rock	275	295
Co Green sand	295	320

DRILLERS REMARKS: set pump  
220'

If well telescopes please sketch and show depths.

GROUND LEVEL

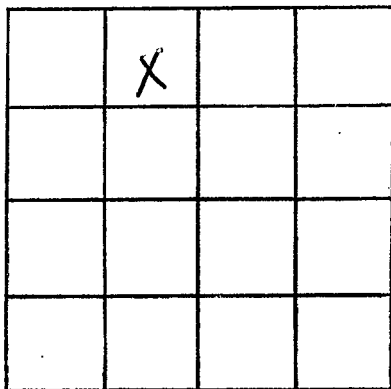

SECTION 16

Please indicate well location X.

ADDITIONAL INFORMATION

If more than one screen,  
show locations of each on sketch.