

MISSISSIPPI DEPARTMENT OF NATURAL RESOURCES

Bureau of Land and Water Resources

Southport Mall

P.O. Box 10631

Jackson, Mississippi 39209

WATER WELL DRILLERS LOG

F 32  
 Newton

4-30-85 date well completed  
 85 McDonald & Hill Trl firm name  
 Newton county well located

LANDOWNER: Tim H Willis  
Newton, MS

(mailing address)

WELL LOCATION:

sec. 36 T 1 N R. 11 E  
3 miles South of Oreataua  
 (distance) (direction) (nearest town)

WELL PURPOSE: Home  
 (home, irrigation, municipal, industrial)


WELL COMPLETION DATA:

- (1) diameter (inches) 4
- (2) total depth (feet) 254
- (3) static water level (feet) 125 below above top of ground.
- (4) casing 4" Pvc 200',  
 (material) (depth)  
2"  
 (size) if telescope, see back
- (5) screen 15' #10 slot,  
 (length) (depth to top)  
2" Pvc  
 (size) (material)
- (6) pump \_\_\_\_\_ (HP) \_\_\_\_\_ (yield gpm)  
 (type power)
- (7) electric log \_\_\_\_\_ (yes or no)

(organization running log)  
1 1/2" rubber seal  
 (8) how well bottom plugged 2" back  
pressure valve

DRILLERS REMARKS:

| description of formations encountered | from | to  |
|---------------------------------------|------|-----|
| Clay & sand                           | 0    | 30  |
| Shale                                 | 30   | 60  |
| st sand                               | 60   | 120 |
| Coarse sand                           | 120  | 150 |
| Brown shale st sand                   | 150  | 162 |
| sandy shale                           | 162  | 170 |
| shale                                 | 170  | 210 |
| sandy st rock                         | 210  | 238 |
| Coarse green sand                     | 238  | 254 |

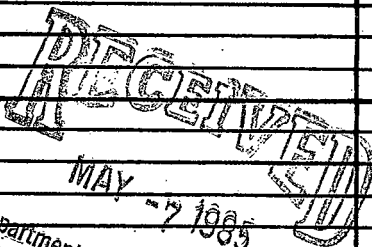

Department of Natural Resources  
 Bureau of Land & Water Resources

