

MISSISSIPPI DEPARTMENT OF NATURAL RESOURCES

Bureau of Land and Water Resources

Southport Mall

P.O. Box 10631

Jackson, Mississippi 39209

WATER WELL DRILLERS LOG

NEWTON
F53

CODED

5-1-86 19 McDONALD + HILL NEWTON
date well completed firm name county well located

LANDOWNER:
PINE RIDGE BAP CHURCH
RH1 DECATUR MS
(mailing address)

description of formations encountered	from	to
<u>CLAY + SAND</u>	<u>0</u>	<u>18</u>
<u>SHALE</u>	<u>18</u>	<u>30</u>
<u>SHELLS</u>	<u>30</u>	<u>65</u>
<u>SHALE</u>	<u>65</u>	<u>110</u>
<u>FINE SAND</u>	<u>110</u>	<u>155</u>
<u>COURSE SAND</u>	<u>155</u>	<u>170</u>

WELL LOCATION:
sec. 19 T. 7 N. R. 11 E
S. W.
5 miles WEST of DECATUR
(distance) (direction) (nearest town)

WELL PURPOSE: CHURCH
(home, irrigation, municipal, industrial)

WELL COMPLETION DATA:

(1) diameter (inches) 2"

(2) total depth (feet) 170'

(3) static water level (feet) 110' below above top of ground.

(4) casing PVC, 160'
(material) (depth)
2"
(size) if telescope see back:

(5) screen 10', 160'
(length) (depth to top)
2, PVC
(size) (material)

(6) pump _____ (HP) _____ (yield gpm)
(type power)

(7) electric log _____ (yes or no)
(organization running log)

(8) how well bottom plugged UNPLUG

CODED


RECEIVED
MAY 14 1986

Department of Natural Resources
Bureau of Land & Water Resources

DRILLERS REMARKS:

If well telescopes please sketch and show depths.

GROUND LEVEL

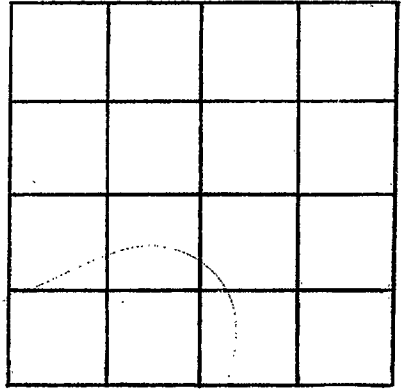

SECTION _____

Please indicate well location X.

ADDITIONAL INFORMATION

If more than one screen, show locations of each on sketch.