

NEWTON
 F 2000
 3-29-76

MISSISSIPPI
 BOARD OF WATER COMMISSIONERS
 416 North State Street
 137 Jackson, Mississippi 39201

WATER WELL DRILLERS LOG

3.29.76 19 MCDONALD #1151 NEWTON
 date well completed firm name county well located

LANDOWNER:
GERALD MITCHELL
R#1 DECATUR
 (mailing address)

WELL LOCATION:
 sec 21 T 7N R 11E
3 miles WEST of DECATUR
 (distance) (direction) (nearest town)

WELL PURPOSE: HOUSE
 (home, irrigation, municipal, industrial)

- WELL COMPLETION DATA:
- (1) diameter (inches) 4"
 - (2) total depth (feet) 290'
 - (3) static water level (feet) 140 below top of ground.
 - (4) casing PVC 220'
 (material) (depth)
4" If telescope see back.
 (size)
 - (5) screen _____
 (length) (depth to top)
 (size) (material)
 - (6) pump 1/2 sub 10
 (HP) (yield gpm)
E
 (type power)
 - (7) electric log _____
 (yes or no)

 (organization running log)
 - (8) how well bottom plugged OPEN

description of formations encountered	from	to
Clay sand	0	26
Blue Clay	26	60
Shale	60	140
sand	140	195
Shale	195	240
sand	240	290

DRILLERS REMARKS: _____


DRYDIP WATER
 WELLS

APR 1 1976

MISSISSIPPI BOARD OF WATER COMMISSIONERS

If well telescopes please sketch and show depths.

GROUND LEVEL

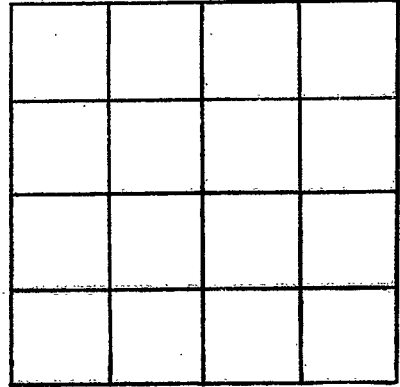

SECTION _____

Please indicate well location X.

ADDITIONAL INFORMATION

If more than one screen,
show locations of each on sketch.