

Newton
F 2006
6-18-76

MISSISSIPPI
 BOARD OF WATER COMMISSIONERS
 416 North State Street
 137 Jackson, Mississippi 39201

WATER WELL DRILLERS LOG


6-18-76 19 McDONALD & SONS NEWTON
 date well completed firm name county well located

LANDOWNER:	description of formations encountered	from	to
<u>Howard A. Good</u>	<u>Play</u>	<u>0</u>	<u>16</u>
<u>Rt #1 DECATUR</u> (mailing address)	<u>Sand Clay</u>	<u>16</u>	<u>32</u>
WELL LOCATION: sec <u>19</u> T <u>7</u> N S R <u>11</u> E W <u>6</u> miles <u>WEST</u> of <u>DECATUR</u> (distance) (direction) (nearest town)	<u>Sand</u>	<u>32</u>	<u>148</u>
WELL PURPOSE: (home) Irrigation, municipal, industrial	<u>Sand & Shell</u>	<u>148</u>	<u>170</u>
WELL COMPLETION DATA: (1) diameter (inches) <u>4"</u> (2) total depth (feet) <u>300</u> (3) static water level (feet) <u>97'</u> below above top of ground. (4) casing <u>PVC</u> <u>212'</u> (material) (depth) <u>4"</u> If telescope see back. (size) (5) screen _____ (length) (depth to top) (size) (material) (6) pump <u>1/2 Sub</u> <u>10</u> (HP) (yield gpm) <u>E</u> (type power) (7) electric log _____ (yes or no) (organization running log) (8) how well bottom plugged <u>OPEN</u>	<u>Soft Shell</u>	<u>170</u>	<u>200</u>
	<u>Shale</u>	<u>200</u>	<u>240</u>
	<u>Rock</u>	<u>240</u>	<u>268</u>
	<u>Sand & Rock</u>	<u>268</u>	<u>300</u>
DRILLERS REMARKS:			

MISSISSIPPI
 BOARD OF WATER COMMISSIONERS
 416 NORTH STATE STREET
 JACKSON, MISSISSIPPI 39201

If well telescopes please sketch and show depths.

GROUND LEVEL

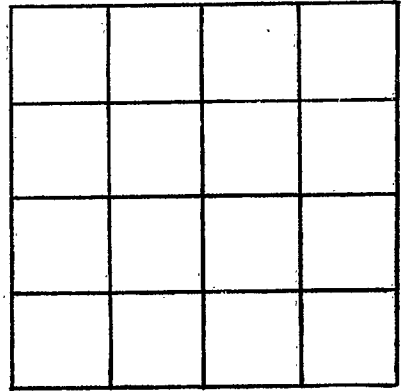

SECTION _____

Please indicate well location X.

ADDITIONAL INFORMATION

If more than one screen,
show locations of each on sketch.