

Newton  
F 2002  
6-21-76

MISSISSIPPI  
 BOARD OF WATER COMMISSIONERS  
 416 North State Street  
 Jackson, Mississippi 39201

WATER WELL DRILLERS LOG


6.21.76 <sup>19</sup> McDONALD + HILL NEWTON  
 date well completed firm name county well located

LANDOWNER:	description of formations encountered	from	to
<u>MARY GLEEN</u>	<u>CLAY</u>	<u>0</u>	<u>5</u>
<u>Rt #1, DECATUR</u> (mailing address)	<u>SAND CLAY</u>	<u>5</u>	<u>20</u>
WELL LOCATION: sec. <u>17</u> T <u>7</u> <sup>N</sup> R. <u>11</u> <sup>E</sup> <u>4</u> miles <u>WEST</u> of <u>DECATUR</u> (distance) (direction) (nearest town)	<u>Shale</u>	<u>20</u>	<u>30</u>
WELL PURPOSE: <u>HOME</u> (home, irrigation, municipal, industrial)	<u>Sand Shale</u>	<u>30</u>	<u>110</u>
WELL COMPLETION DATA: (1) diameter (inches) <u>4"</u>	<u>Brown Shale</u>	<u>110</u>	<u>150</u>
(2) total depth (feet) <u>300'</u>	<u>Sand</u>	<u>150</u>	<u>210</u>
(3) static water level (feet) <u>148'</u> below top of ground.	<u>Shale</u>	<u>210</u>	<u>250</u>
(4) casing <u>PVC 222'</u> (material) (depth) <u>4"</u> if telescope see back. (size)	<u>Sand Shale</u>	<u>250</u>	<u>300</u>
(5) screen _____ (length) (depth to top) (size) (material)			
(6) pump <u>3/4 Sub 6</u> (HP) (yield gpm) <u>E</u> (type power)			
(7) electric log _____ (yes or no) (organization running log)			
(8) how well bottom plugged <u>OPEN</u>			
DRILLERS REMARKS:			

JUN 21 1976  
 MISS. Bd. of Water Comm.

If well telescopes please sketch and show depths.

GROUND LEVEL

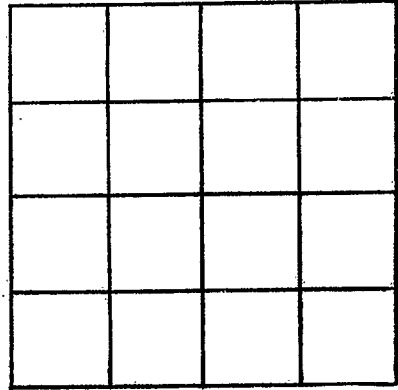

SECTION \_\_\_\_\_

Please indicate well location X.

ADDITIONAL INFORMATION

If more than one screen, show locations of each on sketch.