

Newton
 F 2003
 6-23-76

MISSISSIPPI
 BOARD OF WATER COMMISSIONERS
 416 North State Street
 Jackson, Mississippi 39201

WATER WELL DRILLERS LOG

10.23.76 19 MEDDONALD + SONS NEWTON
 date well completed firm name county well located

LANDOWNER:
 HULAN PHILLIPS
 P.O. DECATUR
 (mailing address)

WELL LOCATION:
 sec. 21 T. 7N R. 11E
 2 miles WEST of DECATUR
 (distance) (direction) (nearest town)

WELL PURPOSE:
 Home
 (home irrigation, municipal, industrial)

- WELL COMPLETION DATA:
- (1) diameter (inches) 4 1/2
 - (2) total depth (feet) 330
 - (3) static water level (feet) 190 below top of ground.
 - (4) casing PVC, 260' (material) (depth)
 4 1/2" if telescope see back. (size)
 - (5) screen (length) (depth to top)
 (size) (material)
 - (6) pump 1-Sub 8 (HP) (yield gpm)
 E (type power)
 - (7) electric log (yes or no)
 (organization running log)
 - (8) how well bottom plugged OPEN


description of formations encountered	from	to
Clay	0	12
Sand Plus	15	46
Shale	46	148
Sand	148	224
Soft shale, ls.	224	250
Shale	256	272
Sand St. Paul	272	330

DRILLERS REMARKS:

RECEIVED
 JUN 29 1976
 MISS. BD. OF WATER COMM.

If well telescopes please sketch and show depths.

GROUND LEVEL

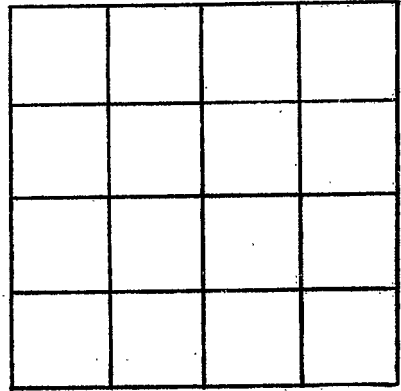

SECTION _____

Please indicate well location X.

ADDITIONAL INFORMATION

If more than one screen, show locations of each on sketch.