

Newton  
F 2005  
6-25-76

MISSISSIPPI  
 BOARD OF WATER COMMISSIONERS  
 416 North State Street  
 Jackson, Mississippi 39201

WATER WELL DRILLERS LOG

6-25-76 19 McDONALD & HALL NEWTON  
 date well completed firm name county well located

LANDOWNER:  
LAMAR WILLIAMS  
Rt 2 DECATUR  
 (mailing address)

WELL LOCATION:  
 sec. 25 T. 70 N. R. 11 E.  
2 miles S WEST of DECATUR  
 (distance) (direction) (nearest town)

WELL PURPOSE: HOUSE  
 (home, irrigation, municipal, industrial)

- WELL COMPLETION DATA:
- (1) diameter (inches) 4 1/2
  - (2) total depth (feet) 320'
  - (3) static water level (feet) 176' below top of ground.
  - (4) casing PVC 240'  
 (material) (depth)  
4 1/2" if telescope see back.  
 (size)
  - (5) screen \_\_\_\_\_  
 (length) (depth to top)  
 (size) (material)
  - (6) pump 3456 6  
 (HP) (yield gpm)  
E  
 (type power)
  - (7) electric log \_\_\_\_\_  
 (yes or no)  
 (organization running log)
  - (8) how well bottom plugged 605N


description of formations encountered	from	to
<u>CLAY</u>	<u>0</u>	<u>22</u>
<u>SHALE</u>	<u>22</u>	<u>120</u>
<u>SAND</u>	<u>120</u>	<u>195</u>
<u>SANDY</u>	<u>195</u>	<u>230</u>
<u>SHALE</u>	<u>230</u>	<u>230</u>
<u>ROCK &amp; SAND</u>	<u>250</u>	<u>270</u>
<u>SAND</u>	<u>270</u>	<u>320</u>

DRILLERS REMARKS:

**RECEIVED**  
 JUN 30 1976  
 MISS. BD. OF WATER COMM

If well telescopes please sketch and show depths.

GROUND LEVEL

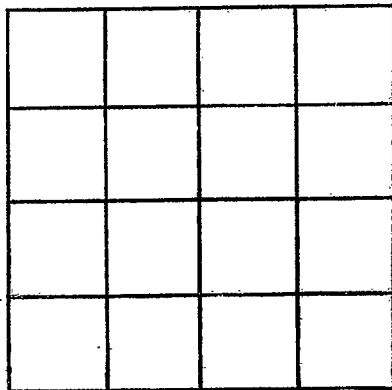

SECTION \_\_\_\_\_

Please indicate well location X.

ADDITIONAL INFORMATION

If more than one screen,  
show locations of each on sketch.