

NEWTON
E 2007
8-6-76

MISSISSIPPI
 BOARD OF WATER COMMISSIONERS
 416 North State Street
 137 Jackson, Mississippi 39201

WATER WELL DRILLERS LOG

8.6.76 19 McDONALD + SONS NEWTON
 date well completed firm name county well located

LANDOWNER:	description of formations encountered	from	to
<u>DEE BARHAM</u>			
<u>R#1 DECATUR</u> (mailing address)	<u>Sand</u>	<u>35</u>	<u>60</u>
WELL LOCATION: sec. <u>3</u> T. <u>13</u> N. R. <u>13</u> E. <u>2</u> miles <u>N WEST</u> of <u>DECATUR</u> (distance) (direction) (nearest town)	<u>Soft Sand</u>	<u>60</u>	<u>98</u>
	<u>Shale</u>	<u>98</u>	<u>134</u>
	<u>Rock Shale</u>	<u>134</u>	<u>160</u>
WELL PURPOSE: <u>HOPE</u> (home, irrigation, municipal, industrial)	<u>Sand & Shale</u>	<u>160</u>	<u>200</u>

- WELL COMPLETION DATA:
- (1) diameter (inches) 24
 - (2) total depth (feet) 200'
 - (3) static water level (feet) 40' below above top of ground.
 - (4) casing Galv. 103'
(material) (depth)
2" if telescope see back.
(size)
 - (5) screen _____
(length) (depth to top)
(size) (material)
 - (6) pump WATER 6
(HP) (yield gpm)
E
(type power)
 - (7) electric log _____
(yes or no)
(organization running log)
 - (8) how well bottom plugged OPEN

RECEIVED


AUG 12 1976

MISS. BD. OF WATER COMMISSIONERS

DRILLERS REMARKS:

If well telescopes please sketch and show depths.

GROUND LEVEL

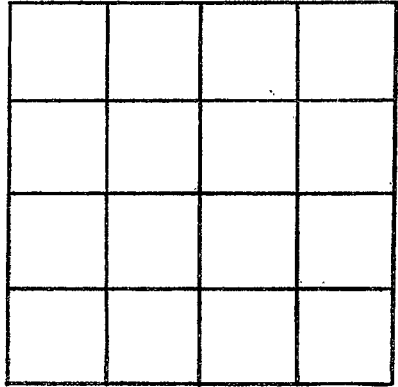

SECTION _____

Please indicate well location X.

ADDITIONAL INFORMATION

If more than one screen, show locations of each on sketch.