

Newton
F 2008
8/19/76

MISSISSIPPI
 BOARD OF WATER COMMISSIONERS
 416 North State Street
 13P Jackson, Mississippi 39201

WATER WELL DRILLERS LOG

8.19.76
 date well completed

McDonald's & Sons
 firm name

NEWTON
 county well located

LANDOWNER:

LARRY BLACKBURN

RH/1 DECATUR
 (mailing address)

WELL LOCATION:

sec. 26 T 7 N R. 11 E
3 miles SOUTH of DECATUR
 (distance) (direction) (nearest town)

WELL PURPOSE:
 (home, irrigation, municipal, industrial)

WELL COMPLETION DATA:

- (1) diameter (inches) 4"
- (2) total depth (feet) 300'
- (3) static water level (feet) 150' below top of ground.
- (4) casing PVC 225'
 (material) (depth)
4"
 (size) if telescope see back.
- (5) screen _____
 (length) (depth to top)
 (size) (material)
- (6) pump 1/2 sub 6
 (HP) (yield gpm)
E
 (type power)
- (7) electric log _____
 (yes or no)
 (organization running log)
- (8) how well bottom plugged OPEN

description of formations encountered

from to

<u>Clas Sand</u>	<u>0</u>	<u>26</u>
<u>Shale</u>	<u>26</u>	<u>52</u>
<u>Sand</u>	<u>52</u>	<u>65</u>
<u>Shale</u>	<u>65</u>	<u>95</u>
<u>Sand & shale</u>	<u>95</u>	<u>120</u>
<u>Sand</u>	<u>120</u>	<u>195</u>
<u>Soft shale</u>	<u>195</u>	<u>210</u>
<u>Shale</u>	<u>210</u>	<u>240</u>
<u>Rock SP Shale</u>	<u>240</u>	<u>260</u>
<u>Sand & shale</u>	<u>260</u>	<u>300</u>

RECEIVED


AUG 20 1976

MISS. BD. OF WATER

DRILLERS REMARKS:

If well telescopes please sketch and show depths.

GROUND LEVEL

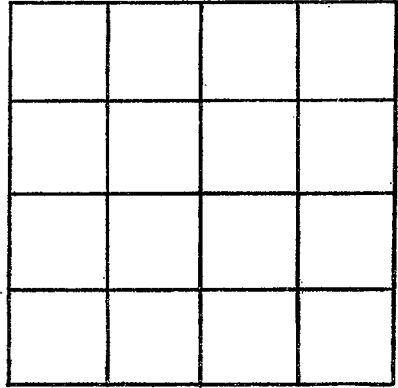

SECTION _____

Please indicate well location X.

ADDITIONAL INFORMATION

If more than one screen, show locations of each on sketch.