

Newton
F 2009
8-20-76

MISSISSIPPI
 BOARD OF WATER COMMISSIONERS
 416 North State Street
 Jackson, Mississippi 39201

WATER WELL DRILLERS LOG


8-20-76 ^{13P} McDONALD & 1121 NEWTON
 date well completed firm name county well located

LANDOWNER:	description of formations encountered	from	to
<u>HOWARD SPENCE</u>			
<u>R#1 DECATUR</u> (mailing address)	<u>Sand</u>	<u>14</u>	<u>26</u>
WELL LOCATION:	<u>Clay</u>	<u>26</u>	<u>35</u>
sec. <u>25</u> T. <u>7N</u> R. <u>11E</u>	<u>Sand</u>	<u>35</u>	<u>82</u>
<u>1</u> miles <u>S. WEST</u> of <u>DECATUR</u> (distance) (direction) (nearest town)	<u>Soft Sands</u>	<u>82</u>	<u>108</u>
WELL PURPOSE: <u>DOMESTIC</u> (home, irrigation, municipal, industrial)	<u>Shale</u>	<u>108</u>	<u>135</u>
WELL COMPLETION DATA:	<u>Rock at Shale</u>	<u>135</u>	<u>160</u>
(1) diameter (inches) <u>4"</u>	<u>Sand at Rock</u>	<u>160</u>	<u>192</u>
(2) total depth (feet) <u>192'</u>			
(3) static water level (feet) <u>80'</u> below above top of ground.			
(4) casing <u>PVC</u> <u>122'</u> (material) (depth)			
<u>4"</u> (size) if telescope see back.			
(5) screen (length) (depth to top)			
(size) (material)			
(6) pump <u>1/2 sub 10</u> (HP) (yield gpm)			
<u>F</u> (type power)			
(7) electric log (yes or no)			
(organization running log)			
(8) how well bottom plugged <u>OPEN</u>			
DRILLERS REMARKS:			

RECEIVED
 AUG 24 1976

If well telescopes please sketch and show depths.

GROUND LEVEL

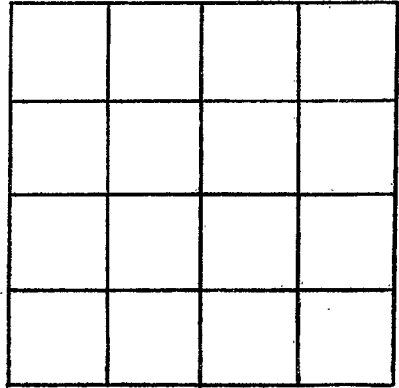

SECTION _____

Please indicate well location X.

ADDITIONAL INFORMATION

If more than one screen, show locations of each on sketch.