

NEWTON
F 2011
9-20-76

MISSISSIPPI
 BOARD OF WATER COMMISSIONERS
 416 North State Street
 Jackson, Mississippi 39201

WATER WELL DRILLERS LOG

9-20-76 date well completed 13T McDonald & Hill firm name NEWTON county well located


LANDOWNER:	description of formations encountered	from	to
SAM WASH	Clay sand	0	16
RD 1 NEWTON (mailing address)	Shale	16	60
WELL LOCATION: sec. 29 T 7 N R 11 E S W 6 miles NORTHWEST NEWTON (distance) (direction) of (nearest town)	Sandy shale	60	95
	Shale	95	140
	Sand	140	265
WELL PURPOSE: (home, irrigation, municipal, industrial)	Sandy shale	265	308
WELL COMPLETION DATA:	Med shale	308	340
(1) diameter (inches) 4"	Rock shale	340	360
(2) total depth (feet) 400'	Sandy shale	360	400
(3) static water level (feet) 180' below top of ground.			
(4) casing 4" (material) 310' (depth) 4" (size) If telescope see back.			
(5) screen (length) (depth to top) (size) (material)			
(6) pump 1.506 (HP) 8 (yield gpm) F (type power)			
(7) electric log (yes or no) (organization running log)			
(8) how well bottom plugged OPEN			
DRILLERS REMARKS:			

RECEIVED
 SEP 22 1976

MISS. BD. OF WATER COMMISSIONERS

If well telescopes please sketch and show depths.

GROUND LEVEL

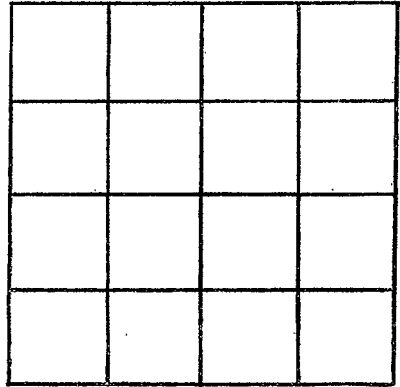

SECTION _____

Please indicate well location X.

ADDITIONAL INFORMATION

If more than one screen,
show locations of each on sketch.