

Newton
 F 2012
 11/16/79

location

MISSISSIPPI
 BOARD OF WATER COMMISSIONERS
 416 North State Street
 Jackson, Mississippi 39201

WATER WELL DRILLERS LOG

11-16-1976 date well completed
 Mc Donald & Hill firm name
 Newton county well located

LANDOWNER:
 Bobby Hendricks
 Rt 1 Decatur Miss
 (mailing address)

description of formations encountered	from	to
clay	0	15
shale	15	33

WELL LOCATION:
 sec 15 T 7 N R 11 E
 S W
 1.2 miles @ W of Decatur
 (distance) (direction) (nearest town)

at Rock & shells	33	37
shale & sand	37	65
sand	65	190

WELL PURPOSE:
 (home, irrigation, municipal, industrial)

sandy shale	190	200
-------------	-----	-----

WELL COMPLETION DATA:
 (1) diameter (inches) 4"
 (2) total depth (feet) 320'
 (3) static water level (feet) 115' below top of ground.
 (4) casing PVC, 235' (material) (depth)
 4" (size) If telescope see back.
 (5) screen (length) (depth to top)
 (size) (material)
 (6) pump 1/2 (HP) 5000 (yield gpm)
 sub (type power)
 (7) electric log (yes or no)
 (organization running log)
 (8) how well bottom plugged open

shale	200	210
Rock & sand	210	230
shale	230	270
Rock & shale	270	295
sand	295	320

DRILLERS REMARKS:


RECEIVED

NOV 22 1976

MISS. BD. OF WATER COMM.

If well telescopes please sketch and show depths.

GROUND LEVEL

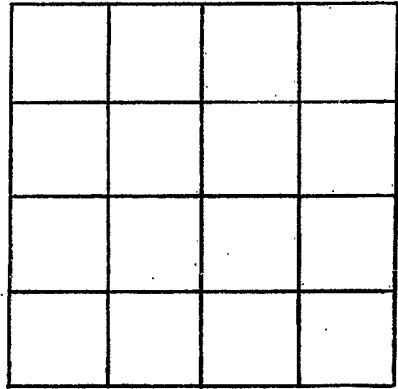

SECTION _____

Please indicate well location X.

ADDITIONAL INFORMATION

If more than one screen, show locations of each on sketch.