

NEWTON
 F 2013
 11-17-76

MISSISSIPPI
 BOARD OF WATER COMMISSIONERS
 416 North State Street
 Jackson, Mississippi 39201

13P

WATER WELL DRILLERS LOG

11-17 1976 date well completed
 Central Drilling Service, Newton firm name
 Newton county well located

LANDOWNER: Charles Sims

Deature, Rtt
Miss
 (mailing address)

WELL LOCATION:

sec 13 T 9 (N) R 11 (E)
1 miles West of Deature
 (distance) (direction) (nearest town)

WELL PURPOSE: Home
 (home, irrigation, municipal, industrial)

WELL COMPLETION DATA:

- (1) diameter (inches) 2"
- (2) total depth (feet) 90
- (3) static water level (feet) 71 below
 top of ground.
- (4) casing Steel, 84
 (material) (depth)
 (size) if telescope see back.
- (5) screen 5, 84
 (length) (depth to top)
1/4", Stainless Steel
 (size) (material)
- (6) pump 1, 5
 (HP) (yield gpm)
2
 (type power)
- (7) electric log No
 (yes or no)

(organization running log)

(8) how well bottom plugged B.W.

description of formations encountered

from

to

description of formations encountered	from	to
<u>Clay</u>	<u>0</u>	<u>60</u>
<u>Sand + Clay</u>		
<u>Ledges</u>	<u>60</u>	<u>80</u>
<u>Sand</u>	<u>80</u>	<u>90</u>


DRILLERS REMARKS:

RECEIVED
 MAY 2 1976

MISS. BD. OF WATER COMMISSIONERS

If well telescopes please sketch and show depths.

GROUND LEVEL

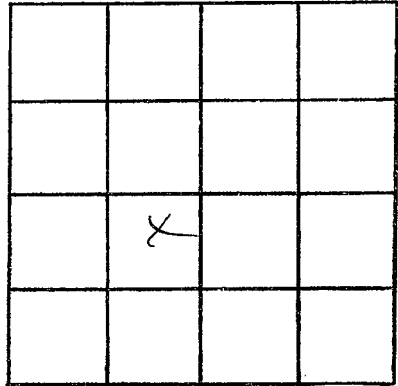

SECTION _____

Please indicate well location X.

ADDITIONAL INFORMATION

Lined area for additional information.

If more than one screen, show locations of each on sketch.