

Newton
F 2014
11-19-76

MISSISSIPPI
BOARD OF WATER COMMISSIONERS
416 North State Street
Jackson, Mississippi 39201

WATER WELL DRILLERS LOG

11-19-1976 date well completed
137 76 McDonald & Hill firm name
Newton county well located

| LANDOWNER: | description of formations encountered | from | to |
|--|---------------------------------------|------|-----|
| Norman Blackburn Rt #1 Decatur (mailing address) | | | |
| WELL LOCATION: | shale | 60 | 75 |
| sec. 14 T 7 N R 11 E 6 miles west of Decatur (distance) (direction) (nearest town) | sandy w/ shells | 75 | 155 |
| WELL PURPOSE: (home, irrigation, municipal, industrial) | shale | 135 | 170 |
| WELL COMPLETION DATA: | sand | 170 | 335 |
| (1) diameter (inches) 4" | sandy shale | 335 | 370 |
| (2) total depth (feet) 480' | shale | 370 | 420 |
| (3) static water level (feet) 185' below top of ground. | rock + shale | 420 | 450 |
| (4) casing PVC 380' (material) (depth) | sand | 450 | 480 |
| 4" if telescope see back. (size) | | | |
| (5) screen (length) (depth to top) | | | |
| (size) (material) | | | |
| (6) pump 3/4 59 P.M. (HP) (yield gpm) | | | |
| sub (type power) | | | |
| (7) electric log (yes or no) | | | |
| (organization running log) | | | |
| (8) how well bottom plugged open | | | |

RECEIVED


NOV 24 1976

MISS. BD. OF WATER COMMISSIONERS

DRILLERS REMARKS:

If well telescopes please sketch and show depths.

GROUND LEVEL

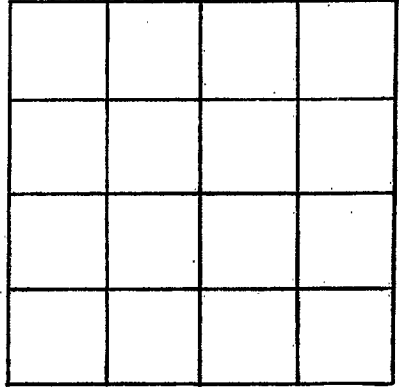

SECTION _____

Please indicate well location X.

ADDITIONAL INFORMATION

A series of horizontal lines providing space for additional information.

If more than one screen, show locations of each on sketch.