

Newton  
F 2015  
11-22-76

MISSISSIPPI  
BOARD OF WATER COMMISSIONERS  
416 North State Street  
13P Jackson, Mississippi 39201

WATER WELL DRILLERS LOG

11-22 date well completed  
13P 76 McDonald + Hill firm name  
Newton county well located

LANDOWNER:	description of formations encountered	from	to
Perry McElhenry Rt #1 Decatur (mailing address)			
WELL LOCATION: sec. 15 T 7 N R 11 E 3 miles W of Decatur (distance) (direction) (nearest town)	shale	20	25
WELL PURPOSE: home (home, irrigation, municipal, industrial)	sand	25	35
WELL COMPLETION DATA: (1) diameter (inches) 4" (2) total depth (feet) 360' (3) static water level (feet) 150' below top of ground. (4) casing PUC 247' (material) (depth) 4" if telescope see back. (size) (5) screen (length) (depth to top) (size) (material) (6) pump 34 6 gpm (HP) (yield gpm) sub (type-power) (7) electric log (yes or no) (organization running log) (8) how well bottom plugged open	sandy shale	35	70
	sandy w shells	70	85
	shale w sand	85	130
	sand	130	217
	sandy shale	217	240
	shale	240	287
	Rock + shell	287	305
	sand + sandy shale	305	367

RECEIVED


NOV 29 1976

DRILLERS REMARKS:

MISS. BD. OF WATER COMMISSIONERS

If well telescopes please sketch and show depths.

GROUND LEVEL

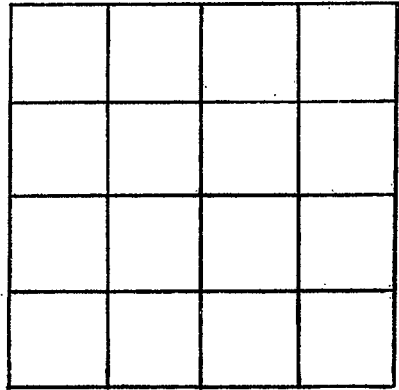

SECTION \_\_\_\_\_

Please indicate well location X.

ADDITIONAL INFORMATION

Series of horizontal lines for entering additional information.

If more than one screen, show locations of each on sketch.