

Newton
 E 216
 12/2/76

MISSISSIPPI
 BOARD OF WATER COMMISSIONERS
 416 North State Street
 137 Jackson, Mississippi 39201

WATER WELL DRILLERS LOG


12-2 19 76 McDonald + Hill Newton
 date well completed firm name county well located

LANDOWNER:	description of formations encountered	from	to
<i>N.W. Willis</i>	<i>Clay + sand</i>	<i>0</i>	<i>35</i>
<i>Rt #3 Decatur</i> (mailing address)	<i>shale + Rock</i>	<i>35</i>	<i>60</i>
WELL LOCATION:	<i>sandy</i>	<i>60</i>	<i>130</i>
sec. <i>21</i> T. <i>7</i> N R. <i>11</i> E <small>S W</small>	<i>shale + sand</i>	<i>130</i>	<i>180</i>
<i>1/2</i> miles <i>West</i> of <i>Decatur</i> (distance) (direction) (nearest town)	<i>sand</i>	<i>180</i>	<i>280</i>
WELL PURPOSE: <i>home</i> (home, irrigation, municipal, industrial)	<i>sandy shale</i>	<i>280</i>	<i>310</i>
WELL COMPLETION DATA:	<i>shale</i>	<i>310</i>	<i>355</i>
(1) diameter (inches) <i>4"</i>	<i>Rock + shell</i>	<i>355</i>	<i>380</i>
(2) total depth (feet) <i>420'</i>	<i>sand</i>	<i>380</i>	<i>420</i>
(3) static water level (feet) <i>205'</i> below top of ground			
(4) casing <i>PVC</i> , <i>320'</i> (material) (depth)			
<i>4"</i> (size) if telescope see back.			
(5) screen (length) (depth to top)			
(size) (material)			
(6) pump <i>34</i> <i>59 gpm</i> (HP) (yield gpm)			
<i>sub</i> (type power)			
(7) electric log (yes or no)			
(organization running log)			
(8) how well bottom plugged <i>open</i>			
DRILLERS REMARKS:			

RECEIVED
 DEC 6 1976
 MISS. BOARD OF WATER COMMISSIONERS

If well telescopes please sketch and show depths.

GROUND LEVEL

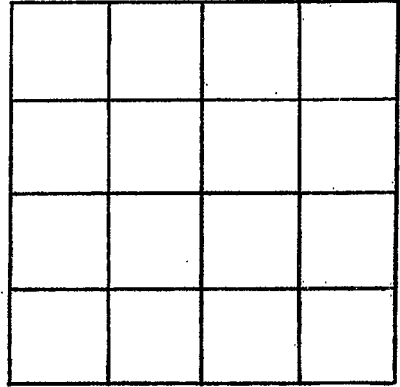

SECTION _____

Please indicate well location X.

ADDITIONAL INFORMATION

If more than one screen, show locations of each on sketch.