

NEWTON
 F 2018
 2/28/77

MISSISSIPPI
 BOARD OF WATER COMMISSIONERS
 416 North State Street
 Jackson, Mississippi 39201

13P

WATER WELL DRILLERS LOG


2-28-77 date well completed
 McDonald & Hill firm name
 Newton county well located

LANDOWNER:	description of formations encountered	from	to
F.W. Brashien			
Rt #1 Deater (mailing address)	shale & lignite	14	30
WELL LOCATION:	shale	30	50
sec. 26 T. 7 N R. 11 E	shale & sand	50	80
2 1/2 miles South W. Deater (distance) (direction) (nearest town)	sand & sand	80	165
WELL PURPOSE: home (home, irrigation, municipal, industrial)	sandy shale	165	190
WELL COMPLETION DATA:	shale	190	225
(1) diameter (inches) 4"	rock & shale	225	250
(2) total depth (feet) 580'	green sand sandy shale	250	280
(3) static water level (feet) 125' below top of ground.			
(4) casing PVC, 2 1/2" (material) (depth)			
4" if telescope see back. (size)			
(5) screen (length) (depth to top)			
(size) (material)			
(6) pump 1/2 HP 50 gpm (HP) (yield gpm)			
F (type power)			
(7) electric log (yes or no)			
(organization running log)			
(8) how well bottom plugged open			
DRILLERS REMARKS:			

RECEIVED
 MAR 27 1977
 MISS. BD. OF WATER COMM.

If well telescopes please sketch and show depths.

GROUND LEVEL

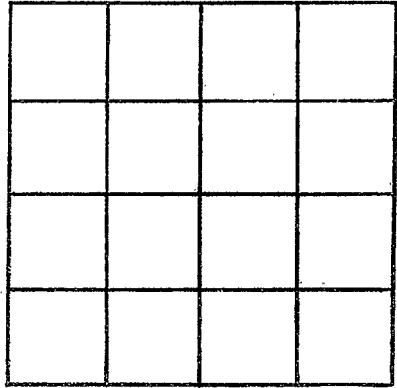

SECTION _____

Please indicate well location X.

ADDITIONAL INFORMATION

If more than one screen, show locations of each on sketch.