

NEWTON  
F 2019  
3-7-77

MISSISSIPPI  
 BOARD OF WATER COMMISSIONERS  
 416 North State Street  
 Jackson, Mississippi 39201

WATER WELL DRILLERS LOG

3-7-77  
 date well completed

13P

McDonald & Hill  
 firm name

Newton  
 county well located


LANDOWNER:	description of formations encountered	from	to
<u>Excell Mapp</u>			
<u>Rt #1 Decatur</u> (mailing address)	<u>sand</u>	<u>30</u>	<u>70</u>
WELL LOCATION:	<u>sandy shale</u>	<u>70</u>	<u>80</u>
sec <u>2</u> T. <u>81</u> N R. <u>11</u> E S W	<u>sand</u>	<u>80</u>	<u>115</u>
<u>5</u> miles <u>NW</u> of <u>Decatur</u> (distance) (direction) (nearest town)	<u>sandy shale</u>	<u>115</u>	<u>155</u>
WELL PURPOSE: <u>home</u> (home, irrigation, municipal, industrial)	<u>shale</u>	<u>155</u>	<u>190</u>
WELL COMPLETION DATA:	<u>Rock + shale</u>	<u>190</u>	<u>210</u>
(1) diameter (inches) <u>4"</u>	<u>green sand sandy sh</u>	<u>210</u>	<u>230</u>
(2) total depth (feet) <u>240'</u>	<u>white sand</u>	<u>230</u>	<u>240</u>
(3) static water level (feet) <u>95'</u> below top of ground.			
(4) casing <u>Pvc</u> , <u>160'</u> (material) (depth) <u>4"</u> (size) if telescope see back.			
(5) screen _____ (length) (depth to top) (size) (material)			
(6) pump <u>1/2</u> <u>650W</u> (HP) (yield gpm) <u>F</u> (type power)			
(7) electric log _____ (yes or no) (organization running log)			
(8) how well bottom plugged <u>open</u>			
DRILLERS REMARKS:			

**RECEIVED**  
 MAR 14 1977

MISS. BD. OF WATER COMM

If well telescopes please sketch and show depths.

GROUND LEVEL

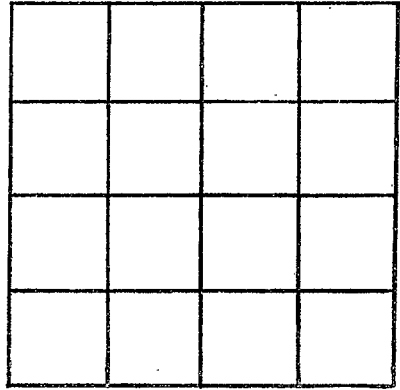

SECTION \_\_\_\_\_

Please indicate well location X.

ADDITIONAL INFORMATION

If more than one screen,  
show locations of each on sketch.