

**MISSISSIPPI
BOARD OF WATER COMMISSIONERS**
416 North State Street
Jackson, Mississippi 39201

NEWTON
F 2020
4-29-77

13P
4-29-77 19 McDonna D & Nell Newton
date well completed firm name county well located


WATER WELL DRILLERS LOG

LANDOWNER:	description of formations encountered	from	to
<u>Guaran Mae Butts</u>	<u>clay & sand</u>	<u>0</u>	<u>30</u>
<u>Rt # 1 Decatur</u> (mailing address)	<u>shale</u>	<u>30</u>	<u>50</u>
WELL LOCATION: sec. <u>23</u> T. <u>7</u> N R. <u>11</u> E <u>3</u> miles <u>West</u> of <u>Decatur</u> (distance) (direction) (nearest town)	<u>shale & sand</u>	<u>50</u>	<u>110</u>
	<u>sand</u>	<u>110</u>	<u>180</u>
	<u>sandy shale</u>	<u>180</u>	<u>210</u>
WELL PURPOSE: <u>home</u> (home, irrigation, municipal, industrial)	<u>shale</u>	<u>210</u>	<u>245</u>
WELL COMPLETION DATA:	<u>Rock & shale</u>	<u>245</u>	<u>265</u>
(1) diameter (inches) <u>4"</u>	<u>sand + sandy shale</u>	<u>265</u>	<u>280</u>
(2) total depth (feet) <u>320'</u>	<u>Rock & sand & shale</u>	<u>280</u>	<u>320</u>
(3) static water level (feet) <u>146</u> ^{below} / _{above} top of ground.			
(4) casing <u>PVC 237'</u> (material) (depth) <u>4</u> If telescope see back. (size)			
(5) screen _____ (length) (depth to top) (size) (material)			
(6) pump <u>1/2</u> <u>600M</u> (HP) (yield gpm) <u>E</u> (type power)			
(7) electric log _____ (yes or no) (organization running log)			
(8) how well bottom plugged <u>open</u>			
DRILLERS REMARKS:			

RECEIVED
MAY 2 1977
MISSISSIPPI BOARD OF WATER COMMISSIONERS

If well telescopes please sketch and show depths.

GROUND LEVEL

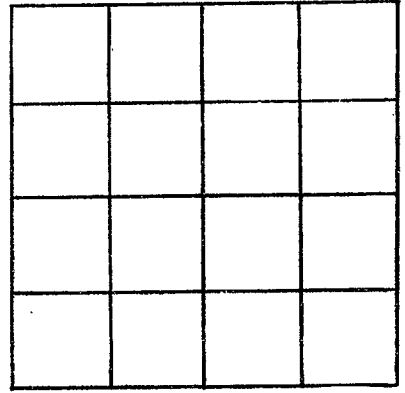

SECTION _____

Please indicate well location X.

ADDITIONAL INFORMATION

If more than one screen, show locations of each on sketch.