

NEWTON
F 2022
6-2-77

MISSISSIPPI
BOARD OF WATER COMMISSIONERS
416 North State Street
Jackson, Mississippi 39201

WATER WELL DRILLERS LOG

6-2-77 ^{13T} 19 McDonald & Hill Newton
date well completed firm name county well located


LANDOWNER:	description of formations encountered	from	to
B. C. Nichols	Clay + sand	0	38
RT #1 Conehatta (mailing address)	sand + shale	30	45
WELL LOCATION: sec. 17 T 7 N R 11 E 10 1/2 miles W of Deaton (distance) (direction) (nearest town)	shale	45	60
WELL PURPOSE: home (home, irrigation, municipal, industrial)	sand	60	130
WELL COMPLETION DATA: (1) diameter (inches) 4" (2) total depth (feet) 320' (3) static water level (feet) 118' below top of ground. (4) casing PVC 238' (material) (depth) 4" (size) if telescope see back. (5) screen (length) (depth to top) (size) (material) (6) pump 1/2 6000 (HP) (yield gpm) E (type power) (7) electric log (yes or no) (organization running log) (8) how well bottom plugged open	shale	130	140
	sand	140	180
	sandy shale	180	225
	shale	225	265
	Rock + shale	265	290
	green sand	290	320
DRILLERS REMARKS:			

RECEIVED
JUN 7 1977

MISS. BD. OF WATER COMM.

If well telescopes please sketch and show depths.

GROUND LEVEL

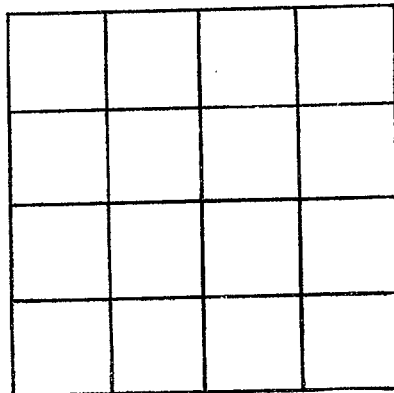

SECTION _____

Please indicate well location X.

ADDITIONAL INFORMATION

If more than one screen, show locations of each on sketch.