

NEWTON
F. 2023
7-19-77

MISSISSIPPI
 BOARD OF WATER COMMISSIONERS
 416 North State Street
 Jackson, Mississippi 39201

13P

WATER WELL DRILLERS LOG

7-19-77 19 McDonald & Hill Newton
 date well completed firm name county well located

LANDOWNER:	description of formations encountered	from	to
<u>Ronald Meadows</u>	<u>clay & sand</u>	<u>0</u>	<u>20</u>
<u>R#1 Decatur</u> (mailing address)	<u>sand</u>	<u>20</u>	<u>45</u>
WELL LOCATION:	<u>sandy shale</u>	<u>45</u>	<u>70</u>
sec. <u>1</u> T. <u>7N</u> R. <u>11E</u> <u>4</u> miles <u>NW</u> of <u>Decatur</u> (distance) (direction) (nearest town)	<u>shale</u>	<u>70</u>	<u>100</u>
WELL PURPOSE: (home, irrigation, municipal, industrial)	<u>Rock & shells</u>	<u>100</u>	<u>130</u>
WELL COMPLETION DATA:	<u>green sand & sandy shale</u>	<u>120</u>	<u>130</u>
(1) diameter (inches) <u>4"</u>	<u>shale & rock</u>	<u>130</u>	<u>145</u>
(2) total depth (feet) <u>160'</u>	<u>sand</u>	<u>145</u>	<u>160</u>
(3) static water level (feet) <u>43'</u> below top of ground.			
(4) casing <u>PVC 95'</u> (material) (depth) <u>4"</u> if telescope see back. (size)			
(5) screen _____ (length) (depth to top) (size) (material)			
(6) pump <u>1/2</u> <u>59 gpm</u> (HP) (yield gpm) <u>E</u> (type power)			
(7) electric log _____ (yes or no) (organization running log)			
(8) how well bottom plugged <u>open</u>			
DRILLERS REMARKS:			


RECEIVED

SEP 26 1977

MISS. BD. OF WATER COMM

If well telescopes please sketch and show depths.

GROUND LEVEL

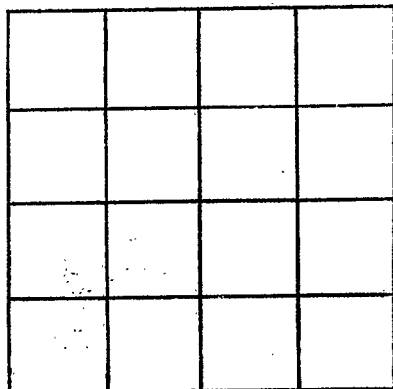

SECTION _____

Please indicate well location X.

ADDITIONAL INFORMATION

If more than one screen,
show locations of each on sketch.