

NEWTON
F 2024
8-8-77

MISSISSIPPI
 BOARD OF WATER COMMISSIONERS
 416 North State Street
 Jackson, Mississippi 39201

WATER WELL DRILLERS LOG

8-8-77
 date well completed

McDonald & Will
 firm name

Newton
 county well located


LANDOWNER:	description of formations encountered	from	to
<u>Homer Burton</u>	<u>clay + st sand</u>	<u>0</u>	<u>35</u>
<u>Rt #1 - Box 246, Decatur</u> (mailing address)	<u>sand</u>	<u>35</u>	<u>64</u>
WELL LOCATION:			
sec. <u>3</u> T. <u>2</u> N. R. <u>11</u> E			
<u>3</u> miles <u>SW</u> of <u>Stratton</u>			
(distance) (direction) (nearest town)			
WELL PURPOSE: <u>home</u> (home, irrigation, municipal, industrial)			
WELL COMPLETION DATA:			
(1) diameter (inches) <u>2"</u>			
(2) total depth (feet) <u>64'</u>			
(3) static water level (feet) <u>48</u> below above top of ground.			
(4) casing <u>PVC</u> , <u>59'</u> (material) (depth)			
<u>3"</u> if telescope see back. (size)			
(5) screen <u>5'</u> , <u>59' to 64'</u> (length) (depth to top)			
<u>3"</u> , <u>PVC</u> (size) (material)			
(6) pump <u>3/4</u> , <u>59 gpm</u> (HP) (yield gpm)			
<u>F</u> (type power)			
(7) electric log <u>—</u> (yes or no)			
(organization running log)			
(8) how well bottom plugged <u>water</u>			
DRILLERS REMARKS:			

RECEIVED
 AUG 15 1977

MISSISSIPPI BOARD OF WATER COMMISSIONERS

If well telescopes please sketch and show depths.

GROUND LEVEL

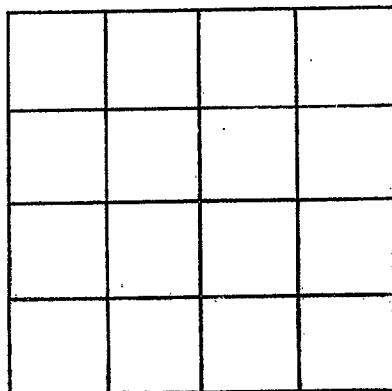

SECTION _____

Please indicate well location X.

ADDITIONAL INFORMATION

If more than one screen, show locations of each on sketch.