

NEWTON

F 2025

2/9/78

MISSISSIPPI  
 BOARD OF WATER COMMISSIONERS  
 416 North State Street  
 Jackson, Mississippi 39201

WATER WELL DRILLERS LOG

2-9-78 date well completed      McDonald & Hill firm name      Newton county well located


LANDOWNER:	description of formations encountered	from	to
Bobby Patrick	clay + sand	0	20
Rt # 3 Box 96 Decatur (mailing address)	sandy shale + st shell	20	45
WELL LOCATION: sec. 24 T <u>N</u> R <u>11E</u> 10 miles W of Decatur (distance) (direction) (nearest town)	sandy shale	45	80
WELL PURPOSE: home (home, irrigation, municipal, industrial)	shale + lignite	80	120
WELL COMPLETION DATA: (1) diameter (inches) 4" (2) total depth (feet) 310' (3) static water level (feet) 155' below above top of ground. (4) casing PVC 242' (material) (depth) 4" If telescope see back. (size) (5) screen (length) (depth to top) (size) (material) (6) pump 1/2 49 PM (HP) (yield gpm) (type power) (7) electric log (yes or no) (organization running log) (8) how well bottom plugged open	sand	120	190
	sandy shale	190	225
	shale	225	262
	rock + shale	262	285
	sand + sandy shale	285	310
DRILLERS REMARKS: net pump 200'			

RECEIVED  
 FEB 13 1978

MISS. BD. OF WATER COMM.

If well telescopes please  
sketch and show depths.

GROUND LEVEL

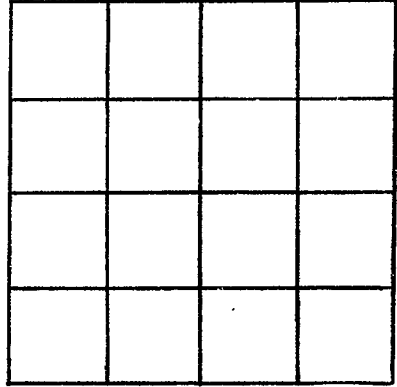

SECTION \_\_\_\_\_

Please indicate well location X.

ADDITIONAL INFORMATION

If more than one screen,  
show locations of each on sketch.