


NEWTON
F 2028
11-1-78

**MISSISSIPPI
BOARD OF WATER COMMISSIONERS**
416 North State Street
Jackson, Mississippi 39201

WATER WELL DRILLERS LOG


11-1-78 19 McDonald & Hill Newton
 date well completed firm name county well located

LANDOWNER:	description of formations encountered	from	to
<u>Vernon Strebeck</u> <u>Decoratus</u> (mailing address)			
<u>Decoratus</u> (mailing address)	<u>sand</u>	<u>15</u>	<u>28</u>
WELL LOCATION: sec. <u>10</u> T. <u>7</u> N. R. <u>11</u> E <u>4</u> miles <u>NW</u> of <u>Decoratus</u> (distance) (direction) (nearest town)	<u>sand shale + lignite</u>	<u>28</u>	<u>60</u>
	<u>sand</u>	<u>60</u>	<u>95</u>
	<u>red clay shale</u>	<u>95</u>	<u>128</u>
WELL PURPOSE: <u>home</u> (home, irrigation, municipal, industrial)	<u>shale</u>	<u>128</u>	<u>161</u>
WELL COMPLETION DATA: (1) diameter (inches) <u>4"</u>	<u>Rock + shells</u>	<u>161</u>	<u>188</u>
(2) total depth (feet) <u>230'</u>	<u>green sand</u>	<u>188</u>	<u>197</u>
(3) static water level (feet) <u>80'</u> below top of ground.	<u>Rock + shale</u>	<u>197</u>	<u>212</u>
(4) casing <u>PVC</u> , <u>150'</u> (material) (depth)	<u>white sand</u>	<u>212</u>	<u>230</u>
<u>4"</u> (size) if telescope see back.			
(5) screen _____ (length) (depth to top)			
(size) _____ (material)			
(6) pump <u>1</u> <u>600m</u> (HP) (y'ld gpm)			
<u>F</u> (type power)			
(7) electric log _____ (yes-or no)			
_____ (organization running log)			
(8) how well bottom plugged <u>open</u>			
DRILLERS REMARKS:			

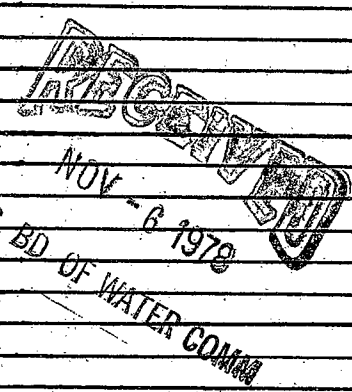

If well telescopes please sketch and show depths.

GROUND LEVEL

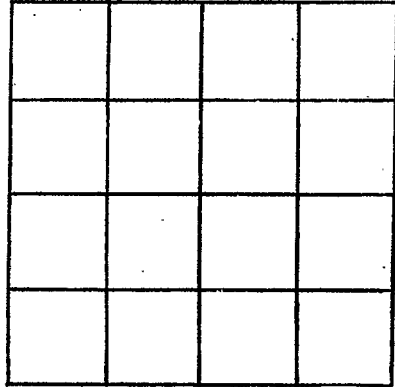

SECTION _____

Please indicate well location X.

ADDITIONAL INFORMATION

If more than one screen, show locations of each on sketch.