

NEWTON
F 2030
5-24-79

MISSISSIPPI
BOARD OF WATER COMMISSIONERS
 416 North State Street
 Jackson, Mississippi 39201

WATER WELL DRILLERS LOG

5-24-79 19 McDonald & Hill Newton
 date well completed firm name county well located

LANDOWNER:	description of formations encountered	from	to
<u>N. W. Willis</u>	<u>clay & sand</u>	<u>0</u>	<u>35</u>
<u>Pl # 1 Decatur</u> (mailing address)	<u>shale & siltstone</u>	<u>35</u>	<u>60</u>
WELL LOCATION: sec. <u>21</u> T. <u>7N</u> R. <u>11E</u> <u>6</u> miles <u>W</u> of <u>Decatur</u> (distance) (direction) (nearest town)	<u>sandy shale at road</u>	<u>60</u>	<u>150</u>
	<u>sand & shale</u>	<u>150</u>	<u>175</u>
	<u>sand</u>	<u>175</u>	<u>280</u>
WELL PURPOSE: <u>home</u> (home, irrigation, municipal, industrial)	<u>sandy shale</u>	<u>280</u>	<u>310</u>
WELL COMPLETION DATA:	<u>shale</u>	<u>310</u>	<u>350</u>
(1) diameter (inches) <u>4"</u>	<u>rock & shell</u>	<u>350</u>	<u>380</u>
(2) total depth (feet) <u>4</u>	<u>green sand & sandstone</u>	<u>380</u>	<u>400</u>
(3) static water level (feet) <u>208'</u> below top of ground.			
(4) casing <u>PVC</u> , <u>3'30"</u> (material) (depth) <u>4"</u> (size) If telescope see back.			
(5) screen _____ (length) (depth to top) (size) (material)			
(6) pump <u>3/4</u> <u>6.0 gpm</u> (HP) (yield gpm) <u>E</u> (type power)			
(7) electric log _____ (yes or no) (organization running log)			
(8) how well bottom plugged <u>open</u>			
DRILLERS REMARKS:			


Miss. Board of Water Comm.

MAY 29 1979

RECEIVED

If well telescopes please sketch and show depths.

GROUND LEVEL

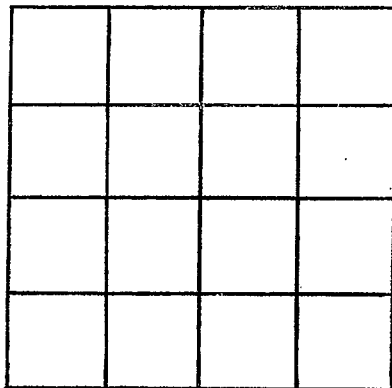

SECTION _____

Please indicate well location X.

ADDITIONAL INFORMATION

If more than one screen,
show locations of each on sketch.