

NEWTON

F 2032

6/19/79

MISSISSIPPI BOARD OF WATER COMMISSIONERS 416 North State Street Jackson, Mississippi 39201

WATER WELL DRILLERS LOG

6-19-79 date well completed

Williamson Drilling Co firm name

Newton county well located

LANDOWNER: Eric Mac Trapp

description of formations encountered

from to

41 Box 78

top soil

0 2

Deater Ms. 39324 (mailing address)

red clay

2 16

blue clay

10 70

sand

70 135

shale

135 230

blue clay

230 315

shale

315 396

sand

396 441

WELL LOCATION:

sec 26 T 70 N R 11 E S W 2 miles SW of Deater (distance) (direction) (nearest town)

WELL PURPOSE: Home (home, irrigation, municipal, industrial)

WELL COMPLETION DATA:

- (1) diameter (inches) 4
(2) total depth (feet) 441
(3) static water level (feet) 210 below top of ground
(4) casing PVC 935 (material) (depth)
(5) screen 4 (size) if telescope see back
(6) pump 3/4 (HP) 7 (yield gpm) electric (type power)
(7) electric log no (yes or no)
(8) how well bottom plugged open

Miss. Board of Water Comm


AUG 22 1979

DRILLERS REMARKS:

RECEIVED

If well telescopes please sketch and show depths.

GROUND LEVEL

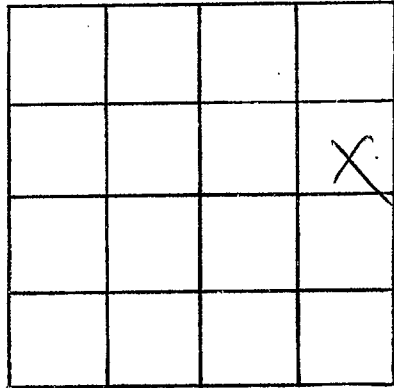

SECTION 26

Please indicate well location X.

ADDITIONAL INFORMATION

If more than one screen, show locations of each on sketch.